

PIKE
 J 41
 2-5-71

MISSISSIPPI
 BOARD OF WATER COMMISSIONERS
 416 North State Street
 Jackson, Mississippi 39201

CODED

WATER WELL DRILLERS LOG

2-5 1971 *F. J. ...* *Pike*
 date well completed firm name county well located

LANDOWNER:	description of formations encountered	from	to
<i>Dudley Conroy</i>	<i>Red Clay</i>	0	20
<i>R.R. Magnolia</i> (mailing address)	<i>Red sand</i>	20	80
WELL LOCATION: sec. <i>18</i> T <i>20</i> S R. <i>9</i> E BR. <i>1</i>	<i>Coarse sand & gravel</i>	80	95
6 miles <i>E</i> of <i>Magnolia</i> (distance) (direction) (nearest town)			
WELL PURPOSE: <i>Flow</i> (home, irrigation, municipal, industrial)			
WELL COMPLETION DATA:			
(1) diameter (inches) <i>4</i>			
(2) total depth (feet) <i>95</i>			
(3) static water level (feet) <i>75</i> below top of ground.			
(4) casing <i>plastic</i> <i>89</i> (material) (depth)			
<i>4</i> If telescope see back. (size)			
(5) screen <i>6</i> <i>89</i> (length) (depth to top)			
<i>4</i> <i>plastic</i> (size) (material)			
(6) pump <i>1/2</i> <i>8</i> (HP) (yield gpm)			
<i>cl</i> (type power)			
(7) electric log <i>74</i> (yes or no)			
(organization running log)			
(8) how well bottom plugged <i>generally</i>			
DRILLERS REMARKS:			


CODED

FEB 11 1971

MISS. B.D. 4B
 WATER DIVISION

If well telescopes please sketch and show depths.

GROUND LEVEL

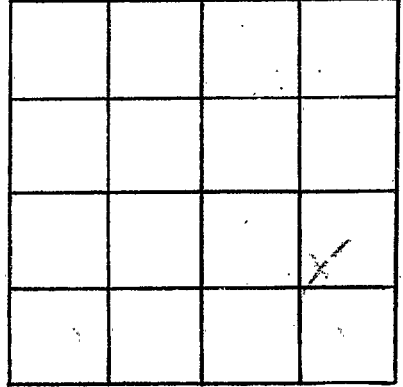

SECTION 10

Please indicate well location X.

ADDITIONAL INFORMATION

If more than one screen, show locations of each on sketch.