

PIKE
 J42
 12-8-69

MISSISSIPPI
 BOARD OF WATER COMMISSIONERS
 416 North State Street
 Jackson, Mississippi 39201

CODED

WATER WELL DRILLERS LOG

12-8 1969 *Fitzgerald* *Pike*
 date well completed firm name county well located

LANDOWNER:
Arthur Williams

R.R. McComb, Miss.
 (mailing address)

WELL LOCATION:
 sec. 18 T 2 N R 9 E
 S W

8 miles E of Maple
 (distance) (direction) (nearest town)

WELL PURPOSE: Domestic
 (home, irrigation, municipal, industrial)

description of formations encountered	from	to
<i>Red clay</i>	<i>0</i>	<i>20</i>
<i>Red sand</i>	<i>20</i>	<i>120</i>
<i>Red clay</i>	<i>120</i>	<i>140</i>
<i>Coarse sand</i>	<i>140</i>	<i>157</i>

WELL COMPLETION DATA:

(1) diameter (inches) 4

(2) total depth (feet) 157

(3) static water level (feet) 100 below above top of ground.

(4) casing Plastic, 149,
 (material) (depth)
4 if telescope see back.
 (size)

(5) screen 8, 149
 (length) (depth to top)
4 (size) Plastic (material)

(6) pump ?, ?
 (HP) (yield gpm)
alc
 (type power)

(7) electric log No
 (yes or no)
 (organization running log)

(8) how well bottom plugged wood peg


CODED

DEC 22 1969

DRILLERS REMARKS:

If well telescopes please sketch and show depths.

GROUND LEVEL

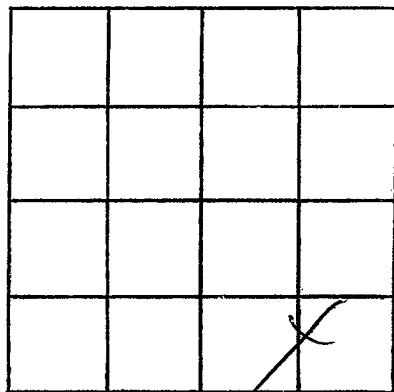

SECTION 18

Please indicate well location X.

ADDITIONAL INFORMATION

If more than one screen,
show locations of each on sketch.