

Pike  
 J 43  
 2-10-70

MISSISSIPPI  
 BOARD OF WATER COMMISSIONERS  
 416 North State Street  
 Jackson, Mississippi 39201

**CODED**

WATER WELL DRILLERS LOG

date well completed Feb 10 1970 firm name Keener Well Drilling Co county well located Pike

LANDOWNER: W.E. Walker  
RT-2  
McLamb  
 (mailing address)

WELL LOCATION:  
 sec. 10 T. 7 R. 9  
11 miles SE of McLamb  
 (distance) (direction) (nearest town)

WELL PURPOSE: Home  
 (home, irrigation, municipal, industrial)

- WELL COMPLETION DATA:
- (1) diameter (inches) 4"
  - (2) total depth (feet) 175
  - (3) static water level (feet) 110 below ~~above~~ top of ground
  - (4) casing Plastic Ballast  
 (material) (depth)
  - \_\_\_\_\_ If telescope see back.  
 (size)
  - (5) screen 6' 169'  
 (length) (depth to top)
  - 4" Plastic  
 (size) (material)
  - (6) pump 1/2 sub 10  
 (HP) (yield gpm)
  - Elect  
 (type power)
  - (7) electric log No  
 (yes or no)
  - \_\_\_\_\_ (organization running log)

description of formations encountered	from	to
Red clay	0	19
Sand & gravel	19	99
white & blue chalk	99	160
Coarse sand	160	175

**CODED**

(8) how well bottom plugged cracking plug


DRILLERS REMARKS: old well hole

FEB 27 1970

MISS. BD. OF WATER

If well telescopes please sketch and show depths.

GROUND LEVEL

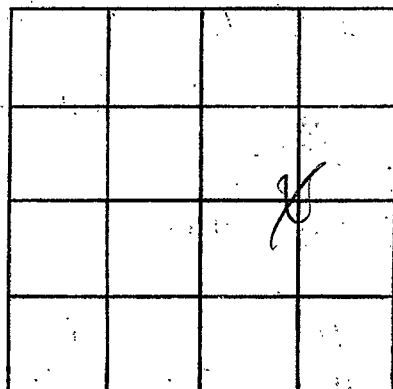

SECTION 10

Please indicate well location X.

ADDITIONAL INFORMATION

If more than one screen,  
show locations of each on sketch.