

MISSISSIPPI
BOARD OF WATER COMMISSIONERS
416 North State Street
Jackson, Mississippi 39201

CODED

RTN 12-21-70

WATER WELL DRILLERS LOG

Exp 2/22/71

PIKE
J 44
11-7-70

11-7-1970
date well completed

1970
firm name

part Martin Water Well
county well located

LANDOWNER:

John Edd. Legant
Jaylor town Miss
(mailing address)

description of formations encountered

from to

top clay
sand

15
80

Gravel

90 100

Chalk clay
Black blue sand

100 218
218 225

good water sand

225 240

WELL LOCATION:

sec. 7 T 2 N 7 R 9 E
S W
12 miles West of Jaylor town
(distance) (direction) (nearest town)

WELL PURPOSE: Home
(home, irrigation, municipal, industrial)

WELL COMPLETION DATA:

- (1) diameter (inches) 4"
- (2) total depth (feet) 140
- (3) static water level (feet) 120 below top of ground.
- (4) casing 10" x 10" sch 40
(material) (depth)

(size) if telescope see back.

- (5) screen 10" sch 40 130
(length) (depth to top)
4" plastic
(size) (material)

- (6) pump 1/2 9
(HP) (yield gpm)

A.C.
(type power)

- (7) electric log no
(yes or no)

(organization running log)

- (8) how well bottom plugged Sand Spuds Backwash

DRILLERS REMARKS:


CODED

DEC 9 1970

MISS. BD. OF
WATER COM.

If well telescopes please sketch and show depths.

GROUND LEVEL

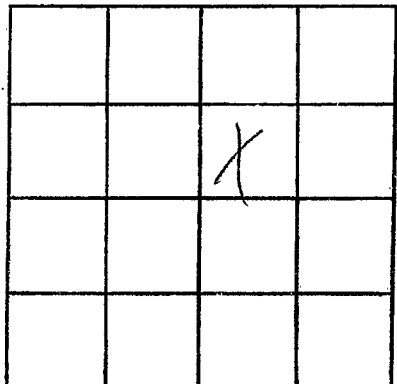

SECTION Z

Please indicate well location X.

ADDITIONAL INFORMATION

If more than one screen, show locations of each on sketch.