

PIKE

MISSISSIPPI  
BOARD OF WATER COMMISSIONERS  
416 North State Street  
Jackson, Mississippi 39201

**CODED**

WATER WELL DRILLERS LOG

PIKE

~~WALTON~~  
J 45  
11-7-70

11-7 1970 Red Martin Water Well - ~~Walton~~  
date well completed firm name county well located

LANDOWNER:

John Edw. Pezant  
Tylertown Miss  
(mailing address)

description of formations encountered

from to

Top clay 18

Sand 18 80

Gravel 80 100

Chalk clay 100 218

Block Flow Sand 218 225

Good Water Sand 225 240

WELL LOCATION:

sec 7 T 2 N R 20 E  
12 miles West of Tylertown  
(distance) (direction) (nearest town)

WELL PURPOSE:

(home, irrigation, municipal, industrial)

WELL COMPLETION DATA:

- (1) diameter (inches) 4"
- (2) total depth (feet) 240
- (3) static water level (feet) 95' <sup>below</sup> above top of ground.
- (4) casing  $\phi$  4" plastic 230 (material) (depth)  
4" (size) if telescope see back.
- (5) screen 10 ft 230 (length) (depth to top)  
4"  $\phi$  12 (size) plastic (material)
- (6) pump 1/2 (HP) 9 (yield gpm)  
115-volt A.C. (type power)
- (7) electric log no (yes or no)

(organization running log)

**CODED**

FEB 22 1971


(8) how well bottom plugged  
Sand & gravel backwash

MISS. BD. OF  
WATER COMMISSIONERS

DRILLERS REMARKS:

If well telescopes please sketch and show depths.

GROUND LEVEL

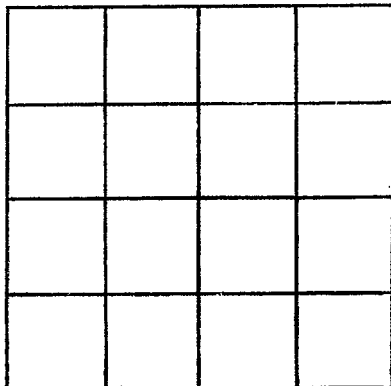

SECTION \_\_\_\_\_

Please indicate well location X.

ADDITIONAL INFORMATION

If more than one screen, show locations of each on sketch.