

PIKE  
 J46  
 2-12-71

MISSISSIPPI  
 BOARD OF WATER COMMISSIONERS  
 416 North State Street  
 Jackson, Mississippi 39201

**CODED**

WATER WELL DRILLERS LOG

2-12 1971 *Fitzgerald Drilling* *Pike*  
 date well completed firm name county well located

LANDOWNER:  
*Julien Owens*  
*R.R. McComb, Miss.*  
 (mailing address)

description of formations encountered	from	to
<i>Red clay</i>	<i>0</i>	<i>20</i>
<i>Red sand</i>	<i>20</i>	<i>110</i>
<i>Red gravel</i>	<i>110</i>	<i>130</i>
<i>Coarse silt &amp; gravel</i>	<i>130</i>	<i>141</i>

WELL LOCATION:  
 sec. 9 T. 2 N. R. 9 E  
10 miles E of McComb  
 (distance) (direction) (nearest town)

WELL PURPOSE:  
*Home*  
 (home, irrigation, municipal, industrial)

- WELL COMPLETION DATA:
- (1) diameter (inches) 4
  - (2) total depth (feet) 141
  - (3) static water level (feet) 110 below above top of ground.
  - (4) casing plaster, 133,  
 (material) (depth)  
4 if telescope see back.  
 (size)
  - (5) screen 8, 133  
 (length) (depth to top)  
4, plaster  
 (size) (material)
  - (6) pump 5  
 (HP) (yield gpm)  
Elco  
 (type power)
  - (7) electric log no  
 (yes or no)  
 (organization running log)
  - (8) how well bottom plugged no

**CODED**


MAR 31 1971

DRILLERS REMARKS:

INCS. DD. OF  
 WATER

If well telescopes please sketch and show depths.

GROUND LEVEL

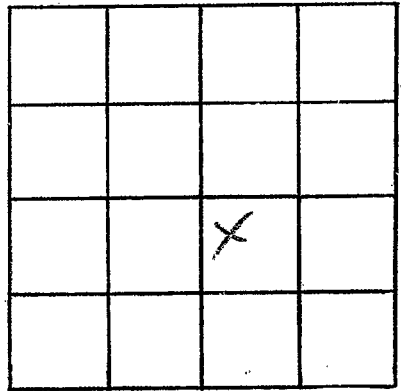

SECTION 9

Please indicate well location X.

ADDITIONAL INFORMATION

If more than one screen, show locations of each on sketch.