

PIKE
547
4-7-71

MISSISSIPPI
BOARD OF WATER COMMISSIONERS
416 North State Street
Jackson, Mississippi 39201

CODED

WATER WELL DRILLERS LOG

4-7 1970 *Edgemoor Well Serv* *Pike*
date well completed firm name county well located

LANDOWNER:
Harold Mizer
R.R. Mazerole Mizer
(mailing address)

WELL LOCATION:
sec 31 T. 20 N. R. 9E
12 miles E of Mazerole
(distance) (direction) (nearest town)

WELL PURPOSE:
Home
(home, irrigation, municipal, industrial)

- WELL COMPLETION DATA:
- (1) diameter (inches) 4
 - (2) total depth (feet) 154
 - (3) static water level (feet) 115 below above top of ground.
 - (4) casing plastic, 146,
(material) (depth)
4 if telescope see back.
(size)
 - (5) screen 8, 146
(length) (depth to top)
4 (size), plastic
(material)
 - (6) pump 1 (HP), 6 (yield gpm)
Elc
(type power)
 - (7) electric log 2
(yes or no)
(organization running log)

description of formations encountered	from	to
<i>Red Clay</i>	<i>0</i>	<i>20</i>
<i>Red Sand</i>	<i>20</i>	<i>90</i>
<i>Red gravel</i>	<i>90</i>	<i>130</i>
<i>white clay</i>	<i>130</i>	<i>140</i>
<i>Coarse sand & gravel</i>	<i>140</i>	<i>154</i>

CODED

MAY 10 1971


MISS. BD. OF
WATER COMMISSIONERS

(8) how well bottom plugged completely

DRILLERS REMARKS:

If well telescopes please sketch and show depths.

GROUND LEVEL

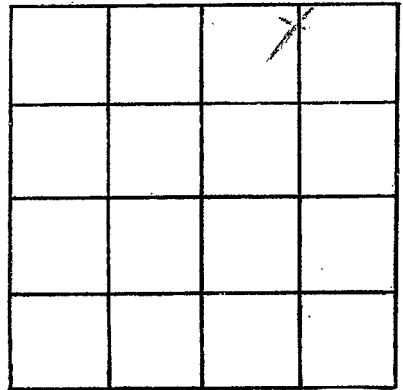

SECTION

Please indicate well location X.

ADDITIONAL INFORMATION

If more than one screen,
show locations of each on sketch.