

MISSISSIPPI
BOARD OF WATER COMMISSIONERS
416 North State Street
Jackson, Mississippi 39201

CODED

WATER WELL DRILLERS LOG

Pike
~~Madison~~

PIKE
J48
4-24-71

April 24 1971
date well completed

Chester Keener
firm name

county well located

LANDOWNER: John P. Simmons
RFD - Tylertown
(mailing address)

description of formations encountered	from	to
clay	0	14
Sand & gravel	14	32
white chalk	32	74
Coarse Sand	74	98

WELL LOCATION:
sec. 2 T. 2 N. R. 9 E
11 miles SE of McComb
(distance) (direction) (nearest town)

WELL PURPOSE: Home
(home, irrigation, municipal, industrial)

- WELL COMPLETION DATA:
- (1) diameter (inches) 4 1/8"
 - (2) total depth (feet) 98
 - (3) static water level (feet) 21 below top of ground.
 - (4) casing Plast. bottom
(material) (depth)
 - (size) if telescope see back.
 - (5) screen 6' 92'
(length) (depth to top)
 - 4" Plast.
(size) (material)
 - (6) pump Bygoner
(HP) (yield gpm)
 - (type power)
 - (7) electric log no
(yes or no)
 - (organization running log)

CODED

(8) how well bottom plugged? wooden plug


DRILLERS REMARKS: New location

MAY 20 1971

MISS. Bd. of
WATER COMMISSIONERS

If well telescopes please sketch and show depths.

GROUND LEVEL

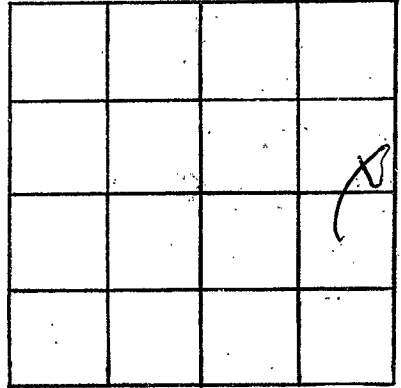

SECTION 2

Please indicate well location X.

ADDITIONAL INFORMATION

If more than one screen, show locations of each on sketch.