

MISSISSIPPI
BOARD OF WATER COMMISSIONERS
416 North State Street
Jackson, Mississippi 39201

CODED

WATER WELL DRILLERS LOG

Pike
J-49
8-4-71

8-4
date well completed

1971 *Pike*
firm name

Pike
county well located

LANDOWNER:
Lee McComb
R.R. McComb
(mailing address)

description of formations encountered	from	to
<i>Red Clay</i>	<i>6</i>	<i>20</i>
<i>Red gravel</i>	<i>20</i>	<i>80</i>
<i>White + blue clay</i>	<i>80</i>	<i>210</i>
<i>Crusher sand</i>	<i>210</i>	<i>225</i>

WELL LOCATION:
sec. 23T 20N R. 9E
S W
11 miles *E* of *McComb*
(distance) (direction) (nearest town)

WELL PURPOSE:
(home, irrigation, municipal, industrial)
Home

- WELL COMPLETION DATA:
- (1) diameter (inches) 4
 - (2) total depth (feet) 225
 - (3) static water level (feet) 80 below above top of ground.
 - (4) casing plastic 217,
(material) (depth)
4 if telescope see back.
(size)
 - (5) screen 8, 217
(length) (depth to top)
4, plastic
(size) (material)
 - (6) pump 1/2, 8
(HP) (yield gpm)
elec
(type power)
 - (7) electric log no
(yes or no)
(organization running log)
 - (8) how well bottom plugged woody

CODED


AUG 11 1971

DRILLERS REMARKS:

MISS. Bd. OF
WATER COMMISSIONERS
JACKSON, MISSISSIPPI

If well telescopes please sketch and show depths.

GROUND LEVEL

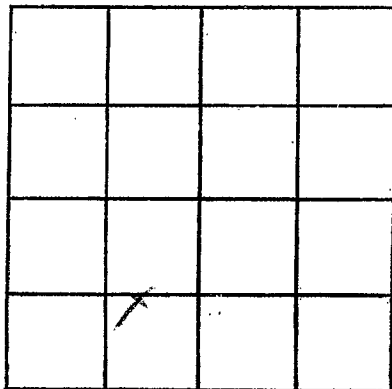

SECTION 23

Please indicate well location X.

ADDITIONAL INFORMATION

If more than one screen,
show locations of each on sketch.