

Pike
 J-50
 7-15-71

MISSISSIPPI
 BOARD OF WATER COMMISSIONERS
 416 North State Street
 Jackson, Mississippi 39201

CODED

WATER WELL DRILLERS LOG

7-15-1971 date well completed 1971 Fitzgerald Well firm name Pike county well located

LANDOWNER:
Wedge Barth
RR. McComb, Miss.
 (mailing address)

description of formations encountered	from	to
Red Clay	6	20
Redgum -	20	80
hard Rocks	80	125
White Clay	125	170
Coarse sand	170	185

WELL LOCATION:
 sec. 9 T. 2 N. R. 9 E
8 miles E of McComb
 (distance) (direction) (nearest town)

WELL PURPOSE: Home
 (home, irrigation, municipal, industrial)

WELL COMPLETION DATA:

(1) diameter (inches) 4

(2) total depth (feet) 185

(3) static water level (feet) 100 below above top of ground.

(4) casing plastic, 177,
 (material) (depth)
4 If telescope see back.
 (size)

(5) screen 8, 177
 (length) (depth to top)
4, plastic
 (size) (material)

(6) pump 1, 6
 (HP) (yield gpm)
Elc
 (type power)

(7) electric log no
 (yes or no)
 (organization running log)

CODED

AUG 11 1971


(8) how well bottom plugged dry

MISS. RD. OF
 WATER COM.

DRILLERS REMARKS:

If well telescopes please sketch and show depths.

GROUND LEVEL

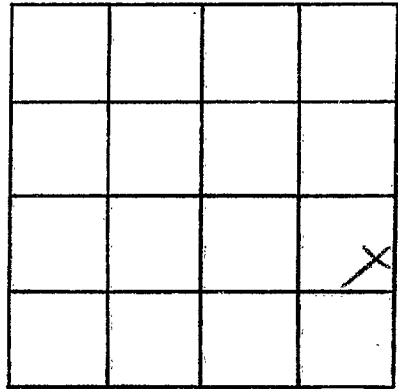

SECTION 9

Please indicate well location X.

ADDITIONAL INFORMATION

If more than one screen,
show locations of each on sketch.