

Pike  
J 51  
8-2-71

MISSISSIPPI  
BOARD OF WATER COMMISSIONERS  
416 North State Street  
Jackson, Mississippi 39201

WATER WELL DRILLERS LOG **CODED**

2 Aug. 1971 S&P Waterwell Pike  
date well completed firm name county well located

LANDOWNER:	description of formations encountered	from	to
Willie Moore Magnolia (mailing address)			
WELL LOCATION: sec. 7 T 2 S R 9 E 0 miles East of Magnolia (distance) (direction) (nearest town)			
WELL PURPOSE: (home, irrigation, municipal, industrial)			
WELL COMPLETION DATA:			
(1) diameter (inches) 4			
(2) total depth (feet) 138			
(3) static water level (feet) 90 below top of ground.			
(4) casing (material) (depth) 138			
(size) if telescope see back.			
(5) screen (length) (depth to top) 6' 132			
(size) (material) 4' 1"			
(6) pump (HP) (yield gpm) 1/2 8			
(type power) split			
(7) electric log (yes or no)			
(organization running log)			
(8) how well bottom plugged wood			
DRILLERS REMARKS:			


**CODED**

OCT 18 1971

MISS. ED. OF  
WATER COM.

If well telescopes please sketch and show depths.

GROUND LEVEL

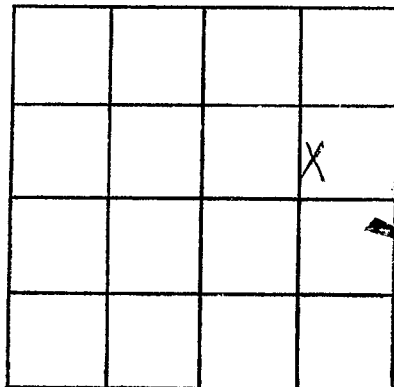

SECTION 7

Please indicate well location X.

ADDITIONAL INFORMATION

Lined area for additional information.

If more than one screen, show locations of each on sketch.