

MISSISSIPPI
BOARD OF WATER COMMISSIONERS
416 North State Street
Jackson, Mississippi 39201

CODED

WATER WELL DRILLERS LOG

Pike
J 52
11-5-71

date well completed Nov 5 1971 firm name Chester Keene county well located Pike

LANDOWNER Stephen Bowers

description of formations encountered

from to

Rt 1, Magnolia

<u>Red clay</u>	<u>0</u>	<u>18</u>
<u>Red sand</u>	<u>18</u>	<u>76</u>
<u>Small gravel sand</u>	<u>76</u>	<u>84</u>
<u>Blue chalk</u>	<u>84</u>	<u>138</u>
<u>Pea gravel sand</u>	<u>138</u>	<u>153</u>

(mailing address)

WELL LOCATION:

sec. 18 T. 2 N R. 9 E
7 miles E of Magnolia
(distance) (direction) (nearest town)

WELL PURPOSE: Home
(home, irrigation, municipal, industrial)

WELL COMPLETION DATA:

- (1) diameter (inches) 4 1/2"
- (2) total depth (feet) 153
- (3) static water level (feet) 80 below top of ground
- (4) casing Plast (material) Bottom (depth)
- (size) if telescope see back.
- (5) screen 6" (length) 147 (depth to top)
- (size) (material) Plast
- (6) pump 1/2 sub (HP) 10 (yield gpm)
- Sheet (type power)
- (7) electric log No (yes or no)

(organization running log)

(8) how well bottom plugged Bottom


DRILLERS REMARKS:

New House

CODED

If well telescopes please sketch and show depths.

GROUND LEVEL

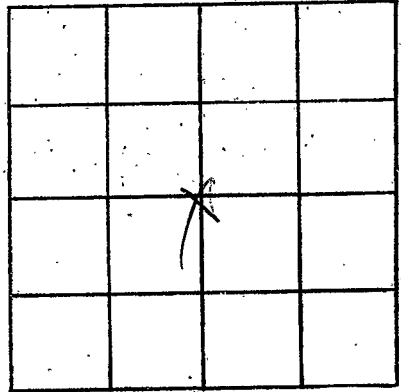

SECTION 18

Please indicate well location X.

ADDITIONAL INFORMATION

If more than one screen, show locations of each on sketch.