

Pike
J53
12-27-71

MISSISSIPPI
BOARD OF WATER COMMISSIONERS
416 North State Street
Jackson, Mississippi 39201

CODED

WATER WELL DRILLERS LOG

12-27-71 date well completed
Fly et well by Pike firm name
Pike county well located

LANDOWNER:
J. Q. Magee
P.O. Magnolia Miss.
(mailing address)

description of formations encountered	from	to
Red Clay	0	20
Red Sand	20	80
Red Gravel	80	120
Red Sand	120	155
Coarse Sand & Gravel	155	164

WELL LOCATION:
sec. 29 T 20 N R 9 E
S W
10 miles E of Magnolia
(distance) (direction) (nearest town)

WELL PURPOSE: Home
(home, irrigation, municipal, industrial)

- WELL COMPLETION DATA:
- (1) diameter (inches) 4
 - (2) total depth (feet) 164
 - (3) static water level (feet) 120 below top of ground.
 - (4) casing Plastic 156 (material) (depth)
 - 4 (size) If telescope see back.
 - (5) screen 8 156 (length) (depth to top)
 - 4 (size) Plastic (material)
 - (6) pump 1 5 (HP) (yield gpm)
 - Electric (type power)
 - (7) electric log no (yes or no)
 - (organization running log)
 - (8) how well bottom plugged analyzed

CODED


JAN 18 1972

DRILLERS REMARKS:

MISS. Bd. of
WATER COMMISSIONERS

If well telescopes please sketch and show depths.

GROUND LEVEL

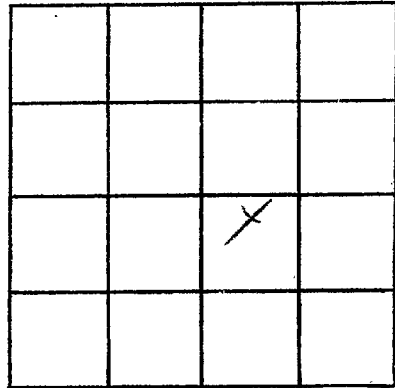

SECTION 29

Please indicate well location X.

ADDITIONAL INFORMATION

If more than one screen,
show locations of each on sketch.