

Pike
 J54
 12-22-71

MISSISSIPPI
 BOARD OF WATER COMMISSIONERS
 416 North State Street
 Jackson, Mississippi 39201

CODED

WATER WELL DRILLERS LOG

12-22 1971 *F. L. Small Well Drilling* *Pike*
 date well completed firm name county well located

LANDOWNER:	description of formations encountered	from	to
<i>Edna Mayer</i>	<i>Red clay</i>	0	20
<i>Rev. McComb, Miss.</i> (mailing address)	<i>Red sand</i>	20	90
WELL LOCATION: sec. <i>8</i> T. <i>2</i> N. R. <i>9</i> E <i>9</i> miles <i>E</i> of <i>McComb</i> (distance) (direction) (nearest town)	<i>Red gravel</i>	90	110
WELL PURPOSE: <i>Home</i> (home, irrigation, municipal, industrial)	<i>Red silt</i>	110	140
WELL COMPLETION DATA:	<i>Coarse sand</i>	140	148
(1) diameter (inches) <i>4</i>			
(2) total depth (feet) <i>148</i>			
(3) static water level (feet) <i>100</i> below top of ground.			
(4) casing <i>Plastic</i> , <i>140</i> (material) (depth)			
<i>4</i> If telescope see back. (size)			
(5) screen <i>8</i> , <i>140</i> (length) (depth to top)			
<i>4</i> , <i>Plastic</i> (size) (material)			
(6) pump <i>1</i> , <i>5</i> (HP) (yield gpm)			
<i>Oil</i> (type power)			
(7) electric log <i>no</i> (yes or no)			
(organization running log)			
(8) how well bottom plugged <i>cleanly</i>			
DRILLERS REMARKS:			


CODED

JAN 18 1972

MISS. BD. OF
 WATER COMMISSIONERS

If well telescopes please sketch and show depths.

GROUND LEVEL

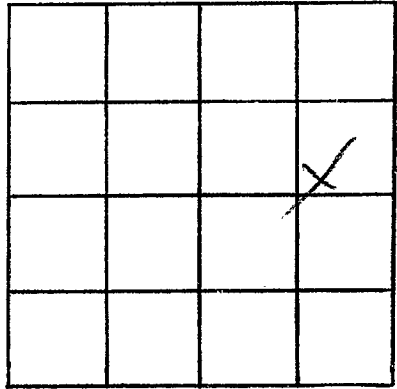

SECTION 8

Please indicate well location X.

ADDITIONAL INFORMATION

A series of horizontal lines for writing additional information.

If more than one screen, show locations of each on sketch.