

Pike
J 56
1-10-72

MISSISSIPPI
 BOARD OF WATER COMMISSIONERS
 416 North State Street
 Jackson, Mississippi 39201

CODED

FEB - 7 1972

WATER WELL DRILLERS LOG

Jan 10 1972
 date well completed

Chatter Keelms
 firm name

Pike
 county well located

LANDOWNER: Jerry Smith
Rt 4, Magnolia

(mailing address)

WELL LOCATION:

sec. 20 T 2 N R 9 E
8 miles ESE of Magnolia
 (distance) (direction) (nearest town)

WELL PURPOSE: farm
 (home, irrigation, municipal, industrial)

WELL COMPLETION DATA:

- (1) diameter (inches) 4"
- (2) total depth (feet) 138
- (3) static water level (feet) 105 below top of ground.
- (4) casing Plast Baltam
 (material) (depth)

(size) If telescope see back.

- (5) screen 6' 132'
 (length) (depth to top)
- 4" Plast
 (size) (material)

- (6) pump Sub 10
 (HP) (yield gpm)
- Select
 (type power)

- (7) electric log no
 (yes or no)

(organization running log)

- (8) how well bottom plugged
washing

DRILLERS REMARKS:

cell well bad

description of formations encountered


from to

Red Sandy chack	0	27
Red Sand	27	52
Hard gravel sand	52	103
Red gravel chack	103	127
Red Sandy Sand	127	130
Small gravel sand	130	138

CODED

If well telescopes please sketch and show depths.

GROUND LEVEL

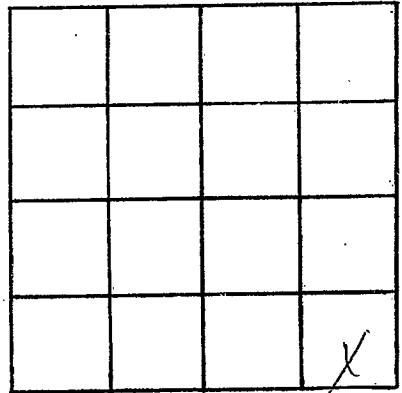

SECTION 20

Please indicate well location X.

ADDITIONAL INFORMATION

If more than one screen, show locations of each on sketch.