

PIKE
J57
2-14-72

CODED

MISSISSIPPI
BOARD OF WATER COMMISSIONERS
416 North State Street
Jackson, Mississippi 39201

FEB 17 1972

MISS. BD. OF
WATER COMMISSIONERS

WATER WELL DRILLERS LOG

2-14

1972 Easley Stafford Water Well

Levon
Pike

date well completed

firm name

county well located

LANDOWNER:

Robert Lee Brumfield

Description of formations encountered

from

to

Route 1, Box 138 A

Magnolia, Miss.
(mailing address)

Top soil	0	5
Clay Shovel	5	70
Gravel	40	110

WELL LOCATION:

sec. 26 T 2 N R 9 E
7 miles West of Lyntown
(distance) (direction) (nearest town)

WELL PURPOSE:

(home, irrigation, municipal, industrial)

WELL COMPLETION DATA:

- (1) diameter (inches) 4
- (2) total depth (feet) 110
- (3) static water level (feet) 70 below ~~above~~ top of ground.
- (4) casing Plastic, 100
(material) (depth)
- 4 If telescope see back.
(size)
- (5) screen 10 ft, 100 ft
(length) (depth to top)
- 4 in, Plastic
(size) (material)
- (6) pump 1/2, 10
(HP) (yield gpm)
- Elec
(power)
- (7) yes or no


CODED

log)

B.W.U.

If well telescopes please sketch and show depths.

GROUND LEVEL

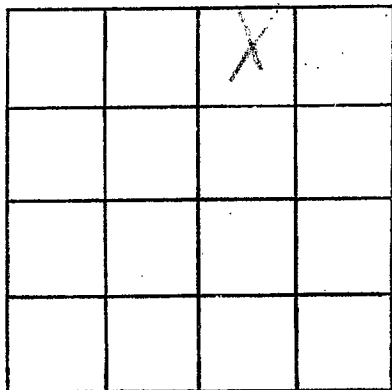

SECTION _____

Please indicate well location X.

ADDITIONAL INFORMATION

If more than one screen, show locations of each on sketch.