

Pike
 J 58
 5-22-72

MISSISSIPPI
 BOARD OF WATER COMMISSIONERS
 416 North State Street
 Jackson, Mississippi 39201

WATER WELL DRILLERS LOG

5-22 19 72
 date well completed

firm name

Edmund Hall & Sons
 county well located

CODED

LANDOWNER:	description of formations encountered	from	to
Bessie Thomas	Red clay	0	20
P.R. McComb Min (mailing address)	Red gravel	20	140
	Coarse sand & large gravel	140	156
WELL LOCATION:			
sec. 20 T 20 R 9 E 2M			
12 miles E of McComb (distance) (direction) (nearest town)			
WELL PURPOSE: Home (home, irrigation, municipal, industrial)			
WELL COMPLETION DATA:			
(1) diameter (inches) 4			
(2) total depth (feet) 154			
(3) static water level (feet) 115 below above top of ground.			
(4) casing Plastic 146 (material) (depth)			
4 (size) if telescope see back.			
(5) screen 8 146 (length) (depth to top)			
4 (size) Plastic (material)			
(6) pump 1/2 9- (HP) (yield gpm)			
Elin (type power)			
(7) electric log (yes or no)			
(organization running log)			
(8) how well bottom plugged Good			
DRILLERS REMARKS:			


CODED

JUN 16 1972

MISS. BD. OF
 WATER COMMISSIONERS

If well telescopes please sketch and show depths.

GROUND LEVEL

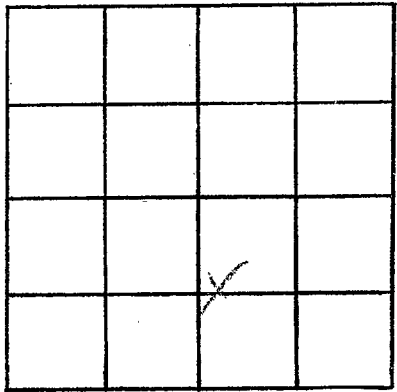

SECTION

Please indicate well location X.

ADDITIONAL INFORMATION

A series of horizontal lines for recording additional information.

If more than one screen, show locations of each on sketch.