

Pike
J 59
8-7-72

MISSISSIPPI
 BOARD OF WATER COMMISSIONERS
 416 North State Street
 Jackson, Mississippi 39201

WATER WELL DRILLERS LOG **CODED**

Aug 7 1972 *Fitzgerald Well Dr* *Pike*
 date well completed firm name county well located

LANDOWNER:	description of formations encountered	from	to
<i>Benton May</i>			
<i>R.R. Marsh</i> (mailing address)	<i>Red Sil</i>	<i>20</i>	<i>80</i>
	<i>Red gravel</i>	<i>80</i>	<i>100</i>
	<i>Red Sil</i>	<i>100</i>	<i>135</i>
	<i>Coarse Sand & gravel</i>	<i>135</i>	<i>150</i>

WELL LOCATION:
 sec. 18 T. 2 (N) R. 9 (E)
3 miles S of Barto
 (distance) (direction) (nearest town)

WELL PURPOSE: Home
 (home, irrigation, municipal, industrial)

- WELL COMPLETION DATA:
- (1) diameter (inches) 4
 - (2) total depth (feet) 150
 - (3) static water level (feet) 100 below above top of ground.
 - (4) casing plastic 142
 (material) (depth)
4 if telescope see back.
 (size)
 - (5) screen 8 142
 (length) (depth to top)
4 plastic
 (size) (material)
 - (6) pump 1/2 10
 (HP) (yield gpm)
elec
 (type power)
 - (7) electric log no
 (yes or no)
 (organization running log)
 - (8) how well bottom plugged well

CODED


SEP 7 1972

DRILLERS REMARKS:

MISS. DEPT. OF REVENUE

If well telescopes please sketch and show depths.

GROUND LEVEL

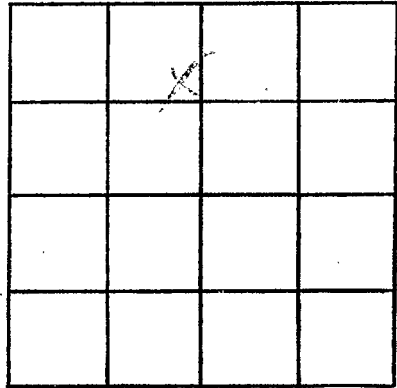

SECTION 13

Please indicate well location X.

ADDITIONAL INFORMATION

If more than one screen,
show locations of each on sketch.