

Pike
J 61
7-13-72

MISSISSIPPI
BOARD OF WATER COMMISSIONERS
416 North State Street
Jackson, Mississippi 39201

CODED


WATER WELL DRILLERS LOG

130 July 1972 date well completed
J. L. Langstater firm name
Pike county well located

LANDOWNER:	description of formations encountered	from	to
<p>Del Rigatti Tylerton (mailing address)</p>	<p>clay red chalk Chalk red</p>	<p>0 70 140 100 75</p>	<p>70 140 60 75 103</p>
<p>WELL LOCATION: sec. <u>24</u> T <u>2</u> N R <u>9</u> E <u>50</u> miles <u>E</u> of <u>Alap.</u> (distance) (direction) (nearest town)</p>			
<p>WELL PURPOSE: (home irrigation, municipal, industrial)</p>			
<p>WELL COMPLETION DATA:</p> <p>(1) diameter (inches) <u>4</u></p> <p>(2) total depth (feet) <u>103</u></p> <p>(3) static water level (feet) <u>45</u> below top of ground</p> <p>(4) casing <u>PI</u> <u>90</u> (material) (depth)</p> <p>(size) if telescope see back.</p> <p>(5) screen <u>6</u> <u>9.7</u> (length) (depth to top)</p> <p>(size) (material)</p> <p>(6) pump <u>1/2</u> <u>8</u> (HP) (yield gpm)</p> <p><u>Electric</u> (type power)</p> <p>(7) electric log (yes or no)</p> <p>(organization running log)</p> <p>(8) how well bottom plugged <u>wood</u></p>	<p>CODED</p>		
<p>DRILLERS REMARKS:</p>	<p>OCT - 5 1972</p> <p>MISS. Bd. OF WATER COMMISSIONERS</p>		

If well telescopes please sketch and show depths.

GROUND LEVEL

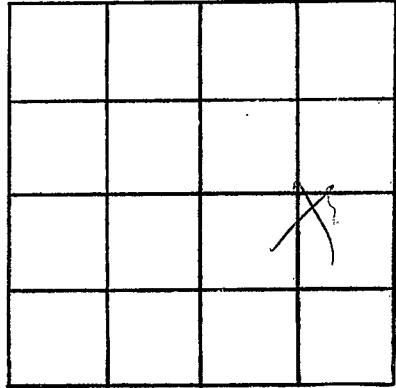

SECTION 34

Please indicate well location X.

ADDITIONAL INFORMATION

If more than one screen,
show locations of each on sketch.