

Pike
J 63
7-11-72

MISSISSIPPI
BOARD OF WATER COMMISSIONERS
416 North State Street
Jackson, Mississippi 39201

CODED

WATER WELL DRILLERS LOG

11 July 1972 J.T. Carmona & Son Pike
date well completed firm name county well located

LANDOWNER:	description of formations encountered	from	to
Wayne Samson McComb, Miss. (mailing address)	clay sand chalk sand	0 10 25 75	10 25 75 825
WELL LOCATION: sec. <u>3</u> T <u>2</u> N R <u>9</u> E <u>10</u> miles <u>East</u> of <u>McComb</u> (distance) (direction) (nearest town)			
WELL PURPOSE: (home, irrigation, municipal, industrial)			
WELL COMPLETION DATA:			
(1) diameter (inches) <u>4</u>			
(2) total depth (feet) <u>135</u>			
(3) static water level (feet) <u>30</u> below top of ground.			
(4) casing <u>PI</u> <u>129</u> (material) (depth)			
_____ if telescope see back. (size)			
(5) screen <u>6</u> <u>129</u> (length) (depth to top)			
_____ <u>PI</u> (size) (material)			
(6) pump <u>1/2</u> <u>8</u> (HP) (yield gpm)			
_____ <u>split</u> (type power)			
(7) electric log _____ (yes or no)			
_____ (organization running log)			
(8) how well bottom plugged <u>wood</u>			
DRILLERS REMARKS:			


CODED

OCT 5 1972

MISS. BD. OF
WATER COMMISSIONERS

If well telescopes please sketch and show depths.

GROUND LEVEL

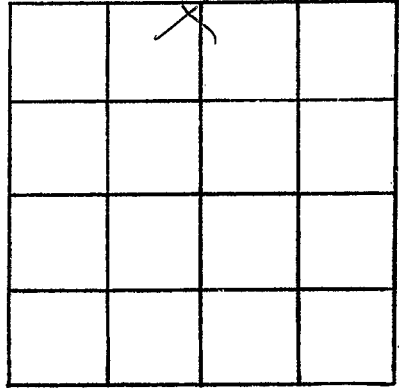

SECTION 3

Please indicate well location X.

ADDITIONAL INFORMATION

If more than one screen,
show locations of each on sketch.