

Pike
J6A
11-10-72

MISSISSIPPI
BOARD OF WATER COMMISSIONERS
416 North State Street
Jackson, Mississippi 39201

CODED

WATER WELL DRILLERS LOG

11-10 1972 Fitzgerald Pike
date well completed firm name county well located

LANDOWNER:
Carell Barnes
R.R. McComb, Miss.
(mailing address)

WELL LOCATION:
sec. 29 T. 2 N R. 9 E
10 miles E of McComb
(distance) (direction) (nearest town)

description of formations encountered	from	to
<u>Red Clay</u>	<u>0</u>	<u>20</u>
<u>Red sand & gravel</u>	<u>20</u>	<u>100</u>
<u>Red sand</u>	<u>100</u>	<u>130</u>
<u>Coarse sand & gravel</u>	<u>130</u>	<u>142</u>

WELL PURPOSE: Home
(home, irrigation, municipal, industrial)

WELL COMPLETION DATA:

(1) diameter (inches) 4

(2) total depth (feet) 142

(3) static water level (feet) 100 below above top of ground.

(4) casing plastic, 134,
(material) (depth)
4 If telescope see back.
(size)

(5) screen 8, 134
(length) (depth to top)
4, plastic
(size) (material)

(6) pump 1/2 9
(HP) (yield gpm)
alum
(type power)

(7) electric log no
(yes or no)
(organization running log)

(8) how well bottom plugged good


CODED

DRILLERS REMARKS:

DEC 7 1972

If well telescopes please sketch and show depths.

GROUND LEVEL

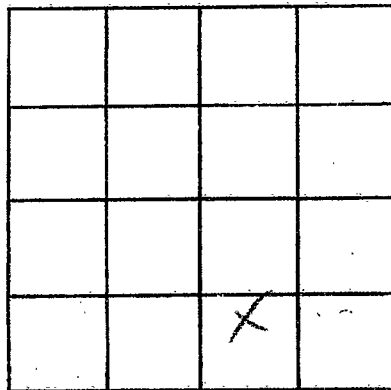

SECTION 29

Please indicate well location X.

ADDITIONAL INFORMATION

Lined area for additional information.

If more than one screen, show locations of each on sketch.