

Pike
J 65
12-5-72

MISSISSIPPI
BOARD OF WATER COMMISSIONERS
416 North State Street
Jackson, Mississippi 39201

WATER WELL DRILLERS LOG

CODED

12-5 1972 Feltz well for Pike
date well completed firm name county well located

LANDOWNER:
Vance Lannon

description of fomations encountered	from	to
Red clay	8	20
Red sand	20	110
Coarse sand gravel	110	123

R.R. Magnolia
(mailing address)

WELL LOCATION:
sec. 34 T 20 S R 9 E
11 miles E of Magnolia
(distance) (direction) (nearest town)

WELL PURPOSE: Home
(home, irrigation, municipal, industrial)

WELL COMPLETION DATA:


- (1) diameter (inches) 4
- (2) total depth (feet) 123
- (3) static water level (feet) 20 below top of ground.
- (4) casing plastic 115
(material) (depth)
4 (size) if telescope see back.
- (5) screen 8 115
(length) (depth to top)
4 (size) plastic (material)
- (6) pump 1/2 10
(HP) (yield gpm)
Elco (type power)
- (7) electric log ny
(yes or no)
(organization running log)
- (8) how well bottom plugged Wood

DRILLERS REMARKS:

12-5-72
J 65

If well telescopes please
sketch and show depths.

GROUND LEVEL

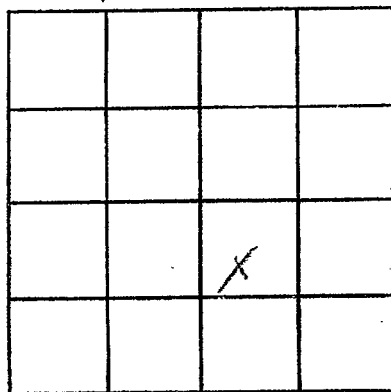

SECTION

34

Please indicate well location X.

ADDITIONAL INFORMATION

If more than one screen,
show locations of each on sketch.