

Pike  
J 66  
12-8-72

MISSISSIPPI  
BOARD OF WATER COMMISSIONERS  
416 North State Street  
Jackson, Mississippi 39201

CODED

WATER WELL DRILLERS LOG

8 Dec 1972 J.T. Cooney & Son Pike  
date well completed firm name county well located


LANDOWNER:	description of formations encountered	from	to
Jane P. Kip Magnolia (mailing address)			
WELL LOCATION:			
sec. <u>B T 2</u> <u>N</u> R. <u>9</u> <u>E</u>			
<u>5</u> miles <u>E</u> of <u>Mag.</u> (distance) (direction) (nearest town)			
WELL PURPOSE: (home, irrigation, municipal, industrial)			
WELL COMPLETION DATA:			
(1) diameter (inches) <u>4</u>			
(2) total depth (feet) <u>154</u>			
(3) static water level (feet) <u>80</u> below above top of ground.			
(4) casing <u>PI</u> <u>148</u> (material) (depth)			
(size) if telescope see back.			
(5) screen <u>6</u> <u>148</u> (length) (depth to top)			
<u>4</u> <u>PI</u> (size) (material)			
(6) pump <u>1/2</u> <u>8</u> (HP) (yield gpm)			
<u>elec</u> (type power)			
(7) electric log _____ (yes or no)			
_____ (organization running log)			
(8) how well bottom plugged <u>wood</u>			
DRILLERS REMARKS:			

CODED

FEB 12 1973

If well telescopes please sketch and show depths.

GROUND LEVEL

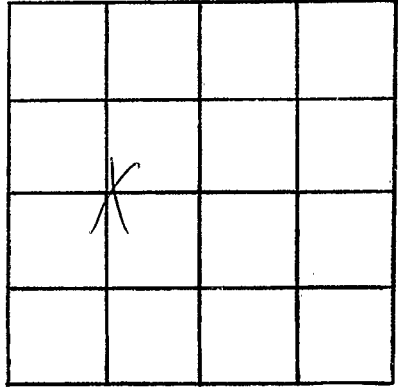

SECTION 12

Please indicate well location X.

ADDITIONAL INFORMATION

If more than one screen, show locations of each on sketch.