

MISSISSIPPI  
BOARD OF WATER COMMISSIONERS  
416 North State Street  
Jackson, Mississippi 39201

**CODED**

WATER WELL DRILLERS LOG

Pike  
J 67  
11-15-72

Nov 15 1972  
date well completed

Chas. Keener  
firm name

Pike  
county well located

LANDOWNER: Wayne Hall -  
Rt. 1 Magnolia

(mailing address)

description of formations encountered

from

to

Red clay	0	13
Red sand	13	65
Grumpy sand	65	90
Red chert	90	115
small gravel & sand	115	136

WELL LOCATION:

sec 20 T 2 N R 9 E  
11 miles ESE of Tylertown  
(distance) (direction) (nearest town)

WELL PURPOSE: Home  
(home, irrigation, municipal, industrial)

WELL COMPLETION DATA:

- (1) diameter (inches) 4 1/2"
- (2) total depth (feet) 136
- (3) static water level (feet) 85 below top of ground
- (4) casing Plast Ballons  
(material) (depth)
- (size) If telescope see back.
- (5) screen 6' 130'  
(length) (depth to top)
- 4" Plast  
(size) (material)
- (6) pump McSub-15  
(HP) (yield gpm)
- Electric  
(type power)
- (7) electric log NO  
(yes or no)

(organization running log)

(8) how well bottom plugged  
wooden plug

DRILLERS REMARKS:  
New location


**CODED**

NO 10 1972

MISS. Bd. of  
WATER COM.

If well telescopes please sketch and show depths.

GROUND LEVEL

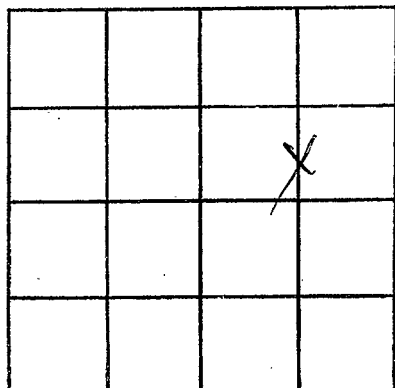

SECTION 26

Please indicate well location X.

ADDITIONAL INFORMATION

If more than one screen,  
show locations of each on sketch.