

Pike

J 68

1-22-73

MISSISSIPPI
 BOARD OF WATER COMMISSIONERS
 416 North State Street
 Jackson, Mississippi 39201

CODED

WATER WELL DRILLERS LOG

Jan 22 1973 Chester Keener Pike
 Date well completed firm name county well located

LANDOWNER: Malcolm Bullack
Rt 1, Magnolia
Box 2, Magnolia
 (mailing address)
 WELL LOCATION:
 sec. 5 T 2 N R 9 E
8 miles ENE of Magnolia
 (distance) (direction) (nearest town)

WELL PURPOSE: Home
 (home, irrigation, municipal, industrial)

WELL COMPLETION DATA:

- (1) diameter (inches) 4"
- (2) total depth (feet) 165
- (3) static water level (feet) 102 below top of ground.
- (4) casing Plast Baller
 (material) (depth)
- (size) if telescope see back.
- (5) screen 6' 160'
 (length) (depth to top)
- 4" Plast
 (size) (material)
- (6) pump 1/2 sub 10
 (HP) (yield gpm)
- Sleeve
 (type power)
- (7) electric log no
 (yes or no)

(organization running log)

(8) how well bottom plugged wooden plug

DRILLERS REMARKS new house


description of formations encountered	from	to
<u>Red Clay</u>	<u>0</u>	<u>12</u>
<u>Red Sand</u>	<u>12</u>	<u>27</u>
<u>Red Chalk</u>	<u>27</u>	<u>52</u>
<u>Red Sand</u>	<u>52</u>	<u>86</u>
<u>Gravel</u>	<u>86</u>	<u>102</u>
<u>Fabulaly sand</u>	<u>102</u>	<u>157</u>
<u>Sand & Gravel</u>	<u>157</u>	<u>165</u>

CODED

MAR 22 1973

If well telescopes please sketch and show depths.

GROUND LEVEL

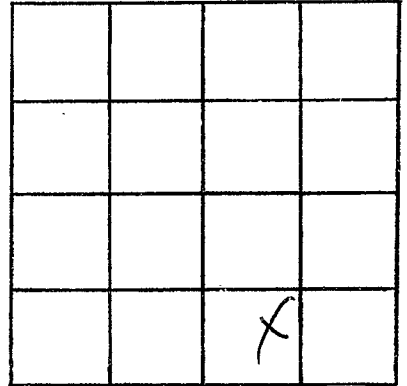

SECTION 5

Please indicate well location X.

ADDITIONAL INFORMATION

If more than one screen,
show locations of each on sketch.