

Pike  
 J 69  
 2-22-73

MISSISSIPPI  
 BOARD OF WATER COMMISSIONERS  
 416 North State Street  
 Jackson, Mississippi 39201

CODE


WATER WELL DRILLERS LOG

22 Feb. 1973 J.T. Covington Pike  
 date well completed firm name county well located

LANDOWNER:	description of formations encountered	from	to
Billy Rogers Magnolia (mailing address)	Clay Chalky sand Sand Chalky sand	0 20 45 60 85	70 45 60 85 130
WELL LOCATION: sec. 17 T 2 N R 9 E 6 miles East of Magnolia (distance) (direction) (nearest town)			
WELL PURPOSE: (home irrigation, municipal, industrial)			
WELL COMPLETION DATA:			
(1) diameter (inches) 4	CODED		
(2) total depth (feet) 130			
(3) static water level (feet) 80 below top of ground.			
(4) casing (material) PL (depth) 124			
(5) screen (length) 6 (depth to top) 124			
(6) pump (size) 4 (material) PL (HP) 1/2 (yield gpm) 8			
(7) electric log (type power) 9600 (yes or no)			
(8) how well bottom plugged (organization running log) wood			
DRILLERS REMARKS:			

If well telescopes please sketch and show depths.

GROUND LEVEL

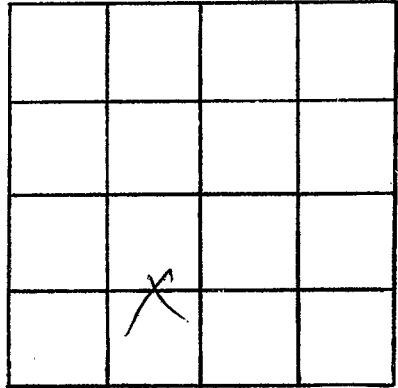

SECTION 17

Please indicate well location X.

ADDITIONAL INFORMATION

If more than one screen,  
show locations of each on sketch.