

PIKE
 J 71
 7-23-73

MISSISSIPPI
 BOARD OF WATER COMMISSIONERS
 416 North State Street
 Jackson, Mississippi 39201

CODE

WATER WELL DRILLERS LOG

28 May 1973 J.T. Cornet & Son Pike
 date well completed firm name county well located

LANDOWNER:

Bonnie Prescott
 Mag.
 (mailing address)

description of formations encountered

from to

clay 0 20
 sand 20 40
 gravel 40 87

WELL LOCATION:

sec. 18 T2 N R 9 E
 8 miles E of Mag.
 (distance) (direction) (nearest town)

WELL PURPOSE:

(home, irrigation, municipal, industrial)

WELL COMPLETION DATA:

- (1) diameter (inches) 4
- (2) total depth (feet) 87
- (3) static water level (feet) 65 below above top of ground.
- (4) casing PL 81
 (material) (depth)
 (size) if telescope see back.
- (5) screen 6 81
 (length) (depth to top)
 4 PL
 (size) (material)
- (6) pump 1/2 8
 (HP) (yield gpm)
 electric
 (type power)
- (7) electric log (yes or no)

(organization running log)


(8) how well bottom plugged wood

DRILLERS REMARKS:

JUL 17 1973

If well telescopes please sketch and show depths.

GROUND LEVEL

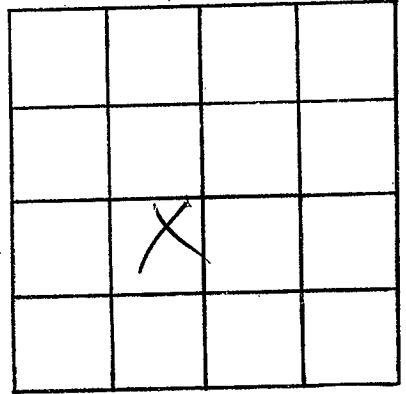

SECTION 18

Please indicate well location X.

ADDITIONAL INFORMATION

If more than one screen,
show locations of each on sketch.