

PIKE
JTZ
7-23-73

MISSISSIPPI **CODED**
 BOARD OF WATER COMMISSIONERS
 416 North State Street
 Jackson, Mississippi 39201

WATER WELL DRILLERS LOG

4 April 1973 J-T-Campbell & Son Pike
 date well completed firm name county well located

LANDOWNER:
 W. L. Eamhart
 Mag.
 (mailing address)

description of formations encountered	from	to
Clay	0	20
Clay sand	20	35
Sand	35	60
Chalk	60	105
Sand	105	154

WELL LOCATION:
 sec. 19 T. 2 N R. 9 E
 5 miles E of Mag.
 (distance) (direction) (nearest town)

WELL PURPOSE:
 (home, irrigation, municipal, industrial)

- WELL COMPLETION DATA:
- (1) diameter (inches) 4
 - (2) total depth (feet) 154
 - (3) static water level (feet) 85 below above top of ground.
 - (4) casing PI 148
 (material) (depth)
4 if telescope see back.
 (size)
 - (5) screen 6 108
 (length) (depth to top)
4 PI
 (size) (material)
 - (6) pump 1/2 8
 (HP) (yield gpm)
dent
 (type power)
 - (7) electric log _____
 (yes or no)
 - (8) how well bottom plugged wood


CODED

DRILLERS REMARKS:

JUL 17 1973

If well telescopes please sketch and show depths.

GROUND LEVEL

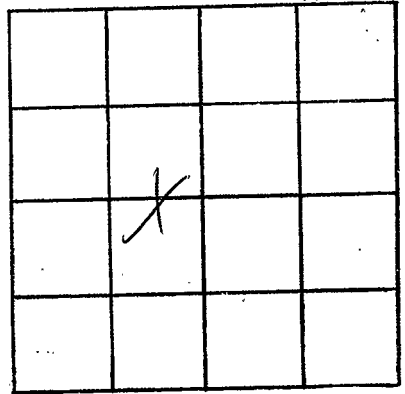

SECTION 18

Please indicate well location X.

ADDITIONAL INFORMATION

If more than one screen, show locations of each on sketch.