

PIKE  
J 75  
10-3-73

MISSISSIPPI  
BOARD OF WATER COMMISSIONERS  
416 North State Street  
Jackson, Mississippi 39201

WATER WELL DRILLERS LOG

CODED

3041  
date well completed

1973

J. T. Langston  
firm name

Pike  
county well located

LANDOWNER:  
Frank Carver  
Mag. Miss.  
(mailing address)

description of formations encountered	from	to
Clay	0	20
Chalk	20	60
Sand shell	60	75
Sand	75	127

WELL LOCATION:  
sec. 28 T. 2 N R. 9 E  
S W  
10 miles E of Mag.  
(distance) (direction) (nearest town)

WELL PURPOSE:  
(home, irrigation, municipal, industrial)

WELL COMPLETION DATA:

(1) diameter (inches) \_\_\_\_\_

(2) total depth (feet) 127

(3) static water level (feet) 75 below top of ground.

(4) casing 11 121  
(material) (depth)  
if telescope see back.

(5) screen 6 121  
(length) (depth to top)  
4 11  
(size) (material)

(6) pump 1/2 8  
(HP) (yield gpm)  
elect  
(type power)

(7) electric log \_\_\_\_\_  
(yes or no)  
(organization running log)

(8) how well bottom plugged wood

CODED


DRILLERS REMARKS:

DEC 12 1973

MISSISSIPPI  
STATE BOARD OF WATER COMMISSIONERS

If well telescopes please sketch and show depths.

GROUND LEVEL

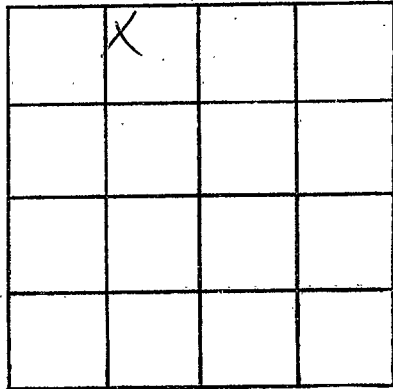

SECTION 28

Please indicate well location X.

ADDITIONAL INFORMATION

If more than one screen,  
show locations of each on sketch.