

PIKE
 J 76
 7-12-74

MISSISSIPPI
 BOARD OF WATER COMMISSIONERS CODED
 416 North State Street
 Jackson, Mississippi 39201

WATER WELL DRILLERS LOG

17 Jul 1974 *Arrow Parkers* *Sedge & Co* *Pike*
 date well completed firm name county well located

LANDOWNER:
Sedge & Co
Magnolia
 (mailing address)

description of formations encountered	from	to
<i>Clay</i>	<i>0</i>	<i>70</i>
<i>red clay</i>	<i>70</i>	<i>45</i>
<i>chert</i>	<i>45</i>	<i>65</i>
<i>sand</i>	<i>65</i>	<i>100</i>

WELL LOCATION:
 sec. *22* T *2* N R. *9* E
7 miles *East* of *May*
 (distance) (direction) (nearest town)

WELL PURPOSE:
 (home, irrigation, municipal, industrial)

WELL COMPLETION DATA:

- (1) diameter (inches) *4*
- (2) total depth (feet) *100*
- (3) static water level (feet) *80* below above top of ground.
- (4) casing *PI* *94*
 (material) (depth)
 (size) If telescope see back.
- (5) screen *6* *94*
 (length) (depth to top)
4 *PI*
 (size) (material)
- (6) pump *1/2* *8*
 (HP) (yield gpm)
elect
 (type power)
- (7) electric log _____
 (yes or no)

 (organization running log)
- (8) how well bottom plugged *wood*


CODED

REGISTERED
 AUG 15 1974

DRILLERS REMARKS:

If well telescopes please sketch and show depths.

GROUND LEVEL

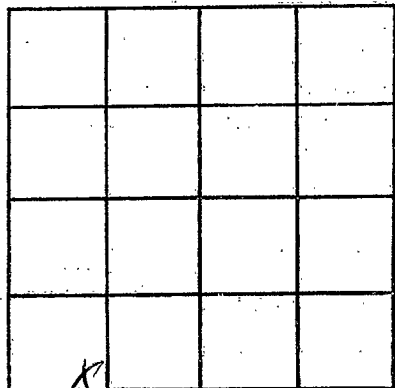

SECTION 30

Please indicate well location X.

ADDITIONAL INFORMATION

If more than one screen, show locations of each on sketch.