

PIKE
J77
7-25-74

MISSISSIPPI
BOARD OF WATER COMMISSIONERS
416 North State Street
Jackson, Mississippi 39201

CODED

WATER WELL DRILLERS LOG

7-25 1974 F. J. ... Pike
date well completed firm name county well located

LANDOWNER:
Willie Lundy
Mr. McComb
(mailing address)

WELL LOCATION:
sec. 9 T. 2 S. R. 9 E.
10 miles E of McComb
(distance) (direction) (nearest town)

description of formations encountered	from	to
<u>Red clay</u>	<u>0</u>	<u>20</u>
<u>Red sand</u>	<u>70</u>	<u>80</u>
<u>Red sand</u>	<u>80</u>	<u>105</u>
<u>white chalk</u>	<u>105</u>	<u>130</u>
<u>Green sand</u>	<u>130</u>	<u>140</u>

WELL PURPOSE: Flow
(home, irrigation, municipal, industrial)

- WELL COMPLETION DATA:
- (1) diameter (inches) 4
 - (2) total depth (feet) 140
 - (3) static water level (feet) 160 below top of ground.
 - (4) casing plastic, 132,
(material) (depth)
4 if telescope see back.
(size)
 - (5) screen 8, 132
(length) (depth to top)
4, plastic
(size) (material)
 - (6) pump 1/2, 10
(HP) (yield gpm)
oh
(type power)
 - (7) electric log no
(yes or no)
(organization running log)
 - (8) how well bottom plugged bad short


DRILLERS REMARKS:

DECEMBER 26 1974

MISS. BU. OF WATER

If well telescopes please sketch and show depths.

GROUND LEVEL

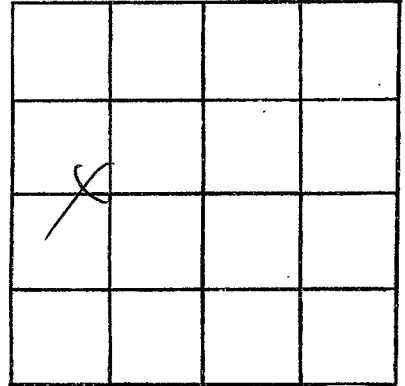

SECTION 9

Please indicate well location X.

ADDITIONAL INFORMATION

If more than one screen,
show locations of each on sketch.