

PIKE
J79
8-27-74

MISSISSIPPI
BOARD OF WATER COMMISSIONERS
416 North State Street
Jackson, Mississippi 39201

CODED

WATER WELL DRILLERS LOG

Aug 27 1974 Chester Kees Pike
date well completed firm name county well located

LANDOWNER	description of formations encountered	from	to
<u>Sarah Brown</u>	<u>clay</u>	<u>0</u>	<u>22</u>
<u>RT 1, Mapalia</u>	<u>Red Chalk</u>	<u>22</u>	<u>46</u>
(mailing address)	<u>Red Sand</u>	<u>46</u>	<u>74</u>
WELL LOCATION:	<u>chalk, gravel sand</u>	<u>74</u>	<u>105</u>
sec. <u>14</u> T. <u>2</u> N. R. <u>9</u> E	<u>small gravel sand</u>	<u>105</u>	<u>113</u>
<u>1 1/2</u> miles <u>E-SE</u> of <u>Mapalia</u>			
(distance) (direction) (nearest town)			

WELL PURPOSE: House
(home, irrigation, municipal, industrial)

- WELL COMPLETION DATA:
- (1) diameter (inches) 4"
 - (2) total depth (feet) 113
 - (3) static water level (feet) 90 below above top of ground.
 - (4) casing Plast Ballast
(material) (depth)
 - (size) if telescope see back.
 - (5) screen 6' 107
(length) (depth to top)
 - 4" Plast
(size) (material)
 - (6) pump 1/2 12
(HP) (yield gpm)
 - elect
(type power)
 - (7) electric log no
(yes or no)

(organization running log)

(8) how well bottom plugged wooden plug


DRILLERS REMARKS: 2" well bot.

RECEIVED
MAY 21 1974

MISS. BD. OF WATER COM.

If well telescopes please sketch and show depths.

GROUND LEVEL

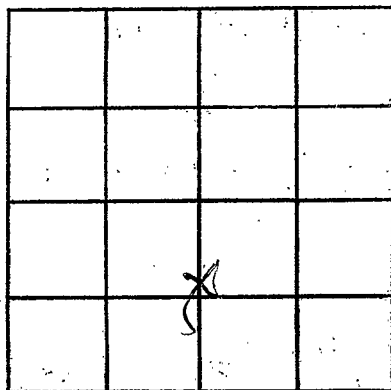

SECTION 14

Please indicate well location X.

ADDITIONAL INFORMATION

If more than one screen,
show locations of each on sketch.