

W. R. Mott Job -

PIKE  
T 82  
1-31-75

MISSISSIPPI  
BOARD OF WATER COMMISSIONERS  
416 North State Street  
Jackson, Mississippi 39201

CODED

WATER WELL DRILLERS LOG

Jan 31 1975 Christopher pipe  
date well completed firm name county well located

LANDOWNER:  
Wallace M. Kenzie  
Rt. Mag.  
(mailing address)

WELL LOCATION:  
sec. 27 T 2 N R 9 E  
10 miles east of Mag.  
(distance) (direction) (nearest town)

WELL PURPOSE: home  
(home, irrigation, municipal, industrial)

- WELL COMPLETION DATA:
- (1) diameter (inches) 4"
  - (2) total depth (feet) 94
  - (3) static water level (feet) 55 below top of ground.
  - (4) casing plastic 88  
(material) (depth)
  - (size) if telescope see back.
  - (5) screen 88  
(length) (depth to top)
  - 4"  
(size) (material)
  - (6) pump 10  
(HP) (yield gpm)
  - electric  
(type power)
  - (7) electric log no  
(yes or no)
  - (organization running log)
  - (8) how well bottom plugged no other plug

description of formations encountered	from	to
<u>Red Clay + sand</u>	<u>0</u>	<u>16</u>
<u>Red sand</u>	<u>16</u>	<u>30</u>
<u>sand &amp; gravel</u>	<u>30</u>	<u>42</u>
<u>pink lobbles</u>	<u>42</u>	<u>60</u>
<u>sand &amp; gravel</u>	<u>60</u>	<u>68</u>
<u>lobbles &amp; chalk</u>	<u>68</u>	<u>83</u>
<u>hard gravel</u>	<u>83</u>	<u>94</u>

CODED


FEB 7 - 1975

DRILLERS REMARKS:  
new house

MISS. BD. OF WATER COMMISSIONERS

If well telescopes please sketch and show depths.

GROUND LEVEL

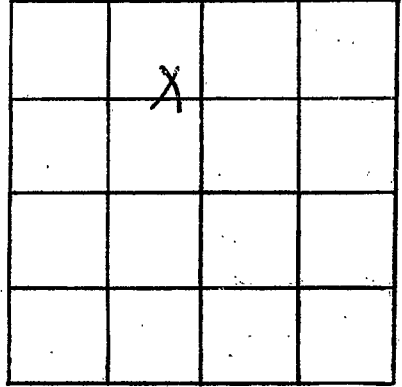

SECTION 22

Please indicate well location X.

ADDITIONAL INFORMATION

If more than one screen, show locations of each on sketch.