

PIKE  
J 83  
1-16-75

MISSISSIPPI  
BOARD OF WATER COMMISSIONERS  
416 North State Street  
Jackson, Mississippi 39201

CODED

WATER WELL DRILLERS LOG

1-16 date well completed      19 75 firm name *Fitzgerald Well Serv*      Pike county well located

LANDOWNER: *Wilhi B. Magee*  
*RR McComb, Miss*  
(mailing address)

description of formations encountered	from	to
<i>Red clay</i>	<i>0</i>	<i>20</i>
<i>Red sand</i>	<i>20</i>	<i>80</i>
<i>White chalk</i>	<i>80</i>	<i>160</i>
<i>Coarse sand</i>	<i>160</i>	<i>180</i>

WELL LOCATION:  
sec. *31* T. *2* N. *9* E  
*8* miles *E* of *Magnolia*  
(distance) (direction) (nearest town)

WELL PURPOSE: *Home*  
(home, irrigation, municipal, industrial)

CODED


- WELL COMPLETION DATA:
- (1) diameter (inches) *4*
  - (2) total depth (feet) *180*
  - (3) static water level (feet) *110* below top of ground.
  - (4) casing *plastic*, *172* (material) (depth)  
*4* If telescope see back. (size)
  - (5) screen *8*, *172* (length) (depth to top)  
*4*, *plastic* (size) (material)
  - (6) pump *1/2*, *10* (HP) (yield gpm)  
*1/2* (type power)
  - (7) electric log *no* (yes or no)  
(organization running log)
  - (8) how well bottom plugged *sand shell*

DRILLERS REMARKS:

REGISTERED  
FEB 1 1975

If well telescopes please sketch and show depths.

GROUND LEVEL

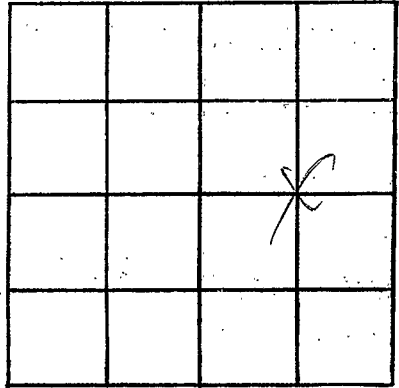

SECTION 31

Please indicate well location X.

ADDITIONAL INFORMATION

If more than one screen, show locations of each on sketch.