

PIKE
J 84
10-19-74

MISSISSIPPI
BOARD OF WATER COMMISSIONERS
416 North State Street JACKSON, MISSISSIPPI 39201
CODED

WATER WELL DRILLERS LOG

Oct 19 1974 date well completed
Chester Lewis firm name
Ita county well located

LANDOWNER: <i>Elmo Lee, RFD - McLamb</i>	description of formations encountered	from	to
(mailing address)	clay	4	12
WELL LOCATION: sec. 10 T. 2 N R. 9 E 130	Sand gravel	12	30
12 miles E. S.E. of <i>McComb</i>	white clay chalk	30	50
WELL PURPOSE: <i>Camp</i> (home, irrigation, municipal industrial)	Coarse sand	50	98
WELL COMPLETION DATA: (1) diameter (inches) <i>4"</i>	Pink loblolly	98	162
(2) total depth (feet) <i>175</i>	Red gravel sand	162	175
(3) static water level (feet) <i>below top of ground. <u>169</u></i>			
(4) casing <i>Plast. Ballast</i> (material) (depth)			
(5) screen <i>6'</i> <i>169</i> (length) (depth to top)			
(6) pump <i>1/2 hp</i> <i>12</i> (HP) (yield gpm)			
(7) electric log <i>NO</i> (yes or no)			
(8) how well bottom plugged <i>wooden plug</i>			
DRILLERS REMARKS: <i>well flowed 20 gal/min</i>			


CODED

REGISTERED
FEB 12 1975

MISS. BOARD OF WATER COMMISSIONERS

If well telescopes please sketch and show depths.

GROUND LEVEL

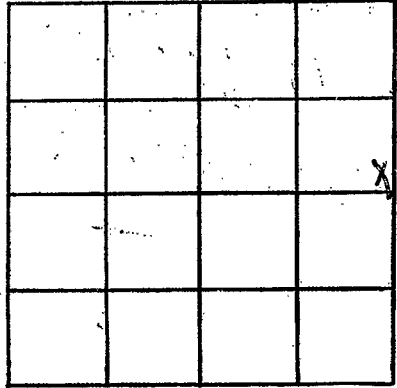

SECTION 10

Please indicate well location X.

ADDITIONAL INFORMATION

If more than one screen,
show locations of each on sketch.