

PIKE  
J 85  
2-22-74

MISSISSIPPI  
BOARD OF WATER COMMISSIONERS  
416 North State Street  
Jackson, Mississippi 39201

CODED

WATER WELL DRILLERS LOG

Feb 22 1974 Chester Keener Pike  
date well completed firm name county well located

LANDOWNER: Albert Jackson  
RT-1,  
Maple  
(mailing address)

description of formations encountered	from	to
<u>Red sandy clay &amp; gravel</u>		
<u>Red sand</u>	<u>0 26</u>	<u>26 44</u>
<u>Sand &amp; gravel</u>	<u>44 66</u>	
<u>Loess</u>	<u>66 90</u>	
<u>Sand &amp; gravel</u>	<u>90 100</u>	

WELL LOCATION:  
sec. 21 T 2 N R. 9 E  
9 1/2 miles E-SE of McComb  
(distance) (direction) (nearest town)


WELL PURPOSE: House  
(home, irrigation, municipal, industrial)

- WELL COMPLETION DATA:
- (1) diameter (inches) 4"
  - (2) total depth (feet) 100
  - (3) static water level (feet) 66 below top of ground
  - (4) casing Plast. bottom  
(material) (depth)
  - (size) if telescope see back.
  - (5) screen 6 94'  
(length) (depth to top)
  - (size) (material)
  - (6) pump brothers  
(HP) (yield gpm)
  - (type power) Electric
  - (7) electric log no  
(yes or no)
  - (organization running log)

(8) how well bottom plugged wooden plug

DRILLERS REMARKS: New house


CODED

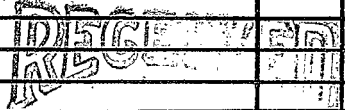

FEB 12 1974

If well telescopes please sketch and show depths.

GROUND LEVEL

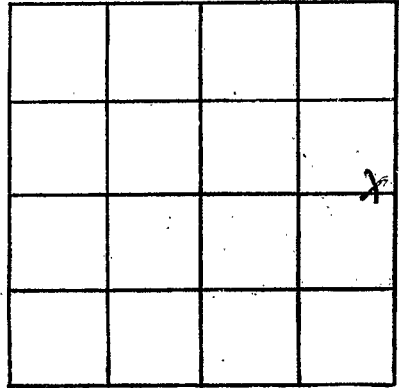

SECTION 21

Please indicate well location X.

ADDITIONAL INFORMATION

If more than one screen, show locations of each on sketch.