

PIKE
FSJ 36
6-21-74

MISSISSIPPI
BOARD OF WATER COMMISSIONERS
416 North State Street
Jackson, Mississippi 39201

CODED

WATER WELL DRILLERS LOG

June 21, 1974 Chester Keene Pike
date well completed firm name county well located

LANDOWNER: Dowdman
At Magnolia
(mailing address)

description of formations encountered	from	to
Red clay	0	17
Red siltstone		
gravel	17	66
19 siltstone sand	66	89

WELL LOCATION:
sec. 26 T 2 N R. 9 E
5 1/2 miles ESE of PIKE
(distance) (direction) (nearest town)

WELL PURPOSE: Home
(home, irrigation, municipal, industrial)

WELL COMPLETION DATA:
(1) diameter (inches) 4"
(2) total depth (feet) 89
(3) static water level (feet) 53 below
top of ground above
(4) casing Plast. Ballam
(material) (depth)
(size) If telescope see back.
(5) screen 6' 83
(length) (depth to top)
10" Plast.
(size) (material)
(6) pump Gayathies
(HP) (yield gpm)
(type power)
(7) electric log No
(yes or no)
(organization running log)

CODED


(8) how well bottom plugged
wooden plug
DRILLERS REMARKS:

DECEMBER 5
FEB 26 1975

MISS. BD. OF WATER COMM.

If well telescopes please sketch and show depths.

GROUND LEVEL

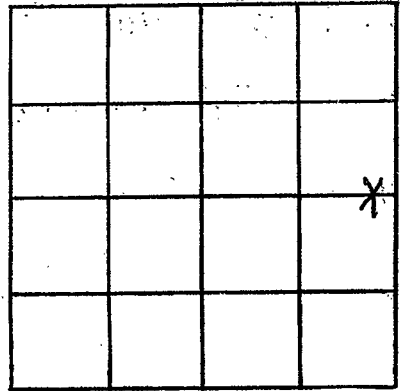

SECTION 26

Please indicate well location X.

ADDITIONAL INFORMATION

If more than one screen, show locations of each on sketch.