

PIKE
 J87
 1-9-74

MISSISSIPPI
 BOARD OF WATER COMMISSIONERS
 416 North State Street
 Jackson, Mississippi 39201 CODED

WATER WELL DRILLERS LOG

Jan 9 1974 Chester Keener Pike
 date well completed firm name county well located

LANDOWNER: Eddie Hook
 Rt-1, Tipton
 (mailing address)

description of formations encountered	from	to
clay	0	22
red sand	22	67
sand & gravel	67	84
chalky sand	84	98
small gravel & sand	98	110

WELL LOCATION:
 sec. 22 T. 2 N. R. 9 E
 9 miles E-S-E of Magnolia
 (distance) (direction) (nearest town)

WELL PURPOSE: Home
 (home, irrigation, municipal, industrial)

- WELL COMPLETION DATA:
- (1) diameter (inches) 4"
 - (2) total depth (feet) 110
 - (3) static water level (feet) 95 below top of ground.
 - (4) casing Plast Bottom
 (material) (depth)
 - (size) If telescope see back.
 - (5) screen 6' 104'
 (length) (depth to top)
 - 4" Plast
 (size) (material)
 - (6) pump Brothers
 (HP) (yield gpm)
 - slit
 (type power)
 - (7) electric log No
 (yes or no)
 - (organization running log)

(8) how well bottom plugged
wooden plug


DRILLERS REMARKS:
New house

CODED

FEB 26 1975

If well telescopes please sketch and show depths.

GROUND LEVEL

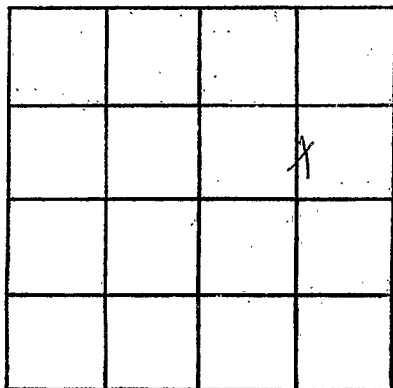

SECTION 22

Please indicate well location X.

ADDITIONAL INFORMATION

If more than one screen, show locations of each on sketch.