

PIKE  
 J 88  
 9-5-74

MISSISSIPPI  
 BOARD OF WATER COMMISSIONERS  
 416 North State Street  
 Jackson, Mississippi 39201

CODED

WATER WELL DRILLERS LOG

april 5 1974 Chester Pease Pete  
 date well completed firm name county well located

LANDOWNER:	description of formations encountered	from	to
<u>Melvin Thomas</u>	<u>clay</u>	<u>0</u>	<u>24</u>
<u>H.C. McLaughlin</u> (mailing address)	<u>red sand</u>	<u>24</u>	<u>62</u>
	<u>gravel sand</u>	<u>62</u>	<u>96</u>
WELL LOCATION: sec. <u>21</u> T. <u>2</u> N R. <u>9</u> E <u>8</u> miles <u>E-SE</u> of <u>Magnolia</u> (distance) (direction) (nearest town)	<u>mixed gravel, sand</u>	<u>96</u>	<u>133</u>
	<u>shell</u>		
WELL PURPOSE: <u>name</u> (home, irrigation, municipal, industrial)	<u>sand &amp; gravel</u>	<u>133</u>	<u>150</u>
WELL COMPLETION DATA:			
(1) diameter (inches) <u>4"</u>			
(2) total depth (feet) <u>150</u>			
(3) static water level (feet) <u>99</u> <u>above</u> top of ground			
(4) casing <u>Plast Bottom</u> (material) (depth)			
(size) If telescope see back.			
(5) screen <u>6'</u> <u>144'</u> (length) (depth to top)			
<u>4"</u> <u>Plast</u> (size) (material)			
(6) pump <u>By owner</u> (HP) (yield gpm)			
<u>Elect</u> (type power)			
(7) electric log <u>NO</u> (yes or no)			
(organization running log)			
(8) how well bottom plugged <u>wooden plug</u>			
DRILLERS REMARKS: <u>old 4" stringer well had</u>			


CODED

RECEIVED  
 FEB 26 1975

MISS. DE. OF WATER

If well telescopes please sketch and show depths.

GROUND LEVEL

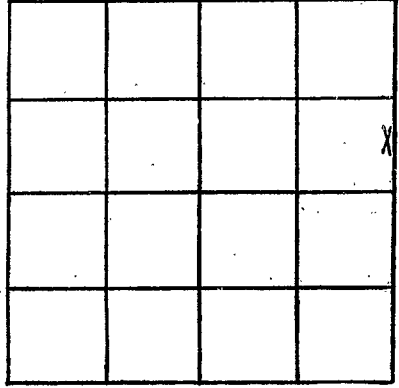

SECTION 20

Please indicate well location X.

ADDITIONAL INFORMATION

A series of horizontal lines for writing additional information, starting below the 'ADDITIONAL INFORMATION' header and extending to the bottom of the page.

If more than one screen, show locations of each on sketch.