

PIKE
J 89
11-12-74

MISSISSIPPI
BOARD OF WATER COMMISSIONERS
416 North State Street
Jackson, Mississippi 39201

CODED

WATER WELL DRILLERS LOG

Pike
~~Waltham~~

Nov. 12 1974 date well completed
Chester Rivers firm name
Waltham county well located

LANDOWNER:
Otis Pigott
Rt. 1 Syletown
(mailing address)

description of formations encountered	from	to
Clay & gravel	0	26
Red sand	26	90
Sand & gravel	90	98
Red Chalk	98	112
Gravel & sand	112	125

WELL LOCATION:
sec. 35 T. 2 N. R. 9 E
10 miles SE of Magnolia
(distance) (direction) (nearest town)

WELL PURPOSE: home
(home, irrigation, municipal, industrial)

WELL COMPLETION DATA:

(1) diameter (inches) 4"

(2) total depth (feet) 125'

(3) static water level (feet) 96' below top of ground.

(4) casing Plastic, bottom
(material) (depth)

(size) If telescope see back.

(5) screen 6' 119'
(length) (depth to top)

4 Plastic
(size) (material)

(6) pump 1/2 10
(HP) (yield gpm)

elist
(type power)

(7) electric log no
(yes or no)

(organization running log)

(8) how well bottom plugged
Wooden Plug

DRILLERS REMARKS:
2" well vent
bad

CODED


DRILLER'S SIGNATURE

MAR 31 1974

MISS. BD. OF WATER COM.

If well telescopes please sketch and show depths.

GROUND LEVEL

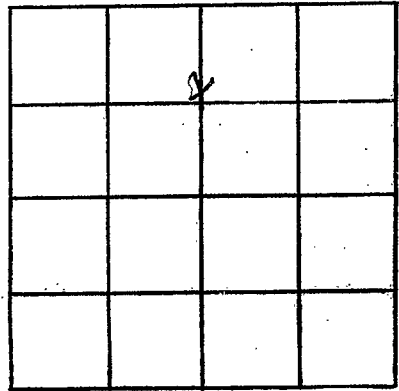

SECTION 35

Please indicate well location X.

ADDITIONAL INFORMATION

If more than one screen, show locations of each on sketch.