

J 91
Pike
4/2/75

MISSISSIPPI
BOARD OF WATER COMMISSIONERS
416 North State Street
Jackson, Mississippi 39201

CODED

WATER WELL DRILLERS LOG

4-2-1975 Fitzgerald Well Serv Pike
date well completed firm name county well located

LANDOWNER: Abraham ton
R.H. McComb, Jr.
(mailing address)

description of formations encountered	from	to
Red Clay	0	20
Red gravel	20	110
Red Sand	110	165
Coarse sand & gravel	165	178

WELL LOCATION:
sec. 19 T 2 N R 9 E
10 miles SE of McComb
(distance) (direction) (nearest town)

WELL PURPOSE: Home
(home, irrigation, municipal, industrial)


- WELL COMPLETION DATA:
- (1) diameter (inches) 4
 - (2) total depth (feet) 178
 - (3) static water level (feet) 120 below above top of ground.
 - (4) casing plastic, 170,
(material) (depth)
4 if telescope see back.
(size)
 - (5) screen 8, 170
(length) (depth to top)
4, plastic
(size) (material)
 - (6) pump 1/2, 10
(HP) (yield gpm)
600
(type power)
 - (7) electric log no
(yes or no)
 - (organization running log)
 - (8) how well bottom plugged Seal block

DRILLERS REMARKS:

RECEIVED
JUN 11 1975

If well telescopes please sketch and show depths.

GROUND LEVEL

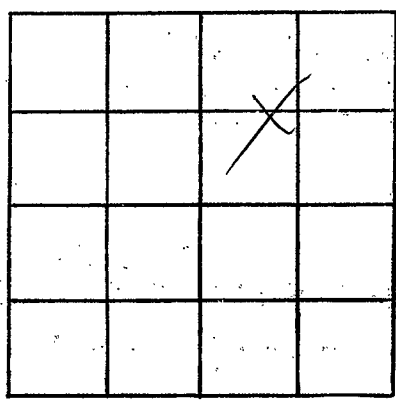

SECTION 19

Please indicate well location X.

ADDITIONAL INFORMATION

A series of horizontal lines for writing additional information.

If more than one screen, show locations of each on sketch.