

Pike
J92
7-2-75

MISSISSIPPI
 BOARD OF WATER COMMISSIONERS
 416 North State Street
 Jackson, Mississippi 39201

WATER WELL DRILLERS LOG

CODED

July 2 1975 Thurman Well Drilling Pike
 date well completed firm name county well located

LANDOWNER:
Mrs Alice Herring
Rt. Magnolia
 (mailing address)

description of formations encountered	from	to
<u>Red clay</u>	<u>0</u>	<u>22</u>
<u>Red Chalky Sand</u>	<u>22</u>	<u>86</u>
<u>Red sand</u>	<u>86</u>	<u>100</u>
Red sand	100	130
<u>hobby conc.</u>	<u>100</u>	<u>130</u>
<u>sand per gravel</u>	<u>130</u>	<u>150</u>


WELL LOCATION:
 sec 30 T 2 N R 9 E ^{14H}
6 1/2 miles E-SE of Magnolia
 (distance) (direction) (nearest town)

WELL PURPOSE: home
 (home, irrigation, municipal, industrial)

CODED

- WELL COMPLETION DATA:
- (1) diameter (inches) 4"
 - (2) total depth (feet) 150
 - (3) static water level (feet) 96 ^{below} _{above} top of ground
 - (4) casing plastic bottom
 (material) (depth)
 - 6' If telescope see back.
 (size)
 - (5) screen 6' 144
 (length) (depth to top)
 - 4" plastic
 (size) (material)
 - (6) pump 1/2 Sul 10
 (HP) (yield gpm)
 - sect
 (type power)
 - (7) electric log no
 (yes or no)
 - (organization running log)
 - (8) how well bottom plugged wood plug

DRILLERS REMARKS:
old plastic well
burst by lightning

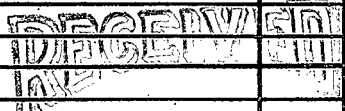

SEP - 8 1975

If well telescopes please sketch and show depths.

GROUND LEVEL

			X

SECTION 30

Please indicate well location X.

ADDITIONAL INFORMATION

If more than one screen, show locations of each on sketch.