

Pelae
593
7-31-75

MISSISSIPPI
 BOARD OF WATER COMMISSIONERS
 416 North State Street
 Jackson, Mississippi 39201

CODED

WATER WELL DRILLERS LOG


July 31 19 75 Pearce Well Drilling Pike
 date well completed firm name county well located

LANDOWNER:	description of formations encountered	from	to
<u>Claude Williams</u> <u>Pt 2 McComb</u> (mailing address)			
WELL LOCATION: sec. <u>8</u> T <u>2</u> N R <u>9</u> E <u>134</u> <u>4</u> miles <u>South</u> of <u>Adams</u> (distance) (direction) (nearest town)			
WELL PURPOSE: <u>Home</u> (home, irrigation, municipal, industrial)			
WELL COMPLETION DATA: (1) diameter (inches) <u>4"</u> (2) total depth (feet) <u>125</u> (3) static water level (feet) <u>70</u> below above top of ground. (4) casing <u>plastic bottom</u> (material) (depth) <input checked="" type="checkbox"/> If telescope see back. (size) (5) screen <u>6"</u> <u>119</u> (length) (depth to top) <u>4</u> <u>plastic</u> (size) (material) (6) pump <u>1/2 Sub</u> <u>10</u> (HP) (yield gpm) <u>1/2 HP</u> (type power) (7) electric log <u>no</u> (yes or no) (organization running log) (8) how well bottom plugged <u>wooden plug</u>			
DRILLERS REMARKS: <u>no house location</u>			

RECEIVED
 JUL 26 1975

If well telescopes please sketch and show depths.

GROUND LEVEL

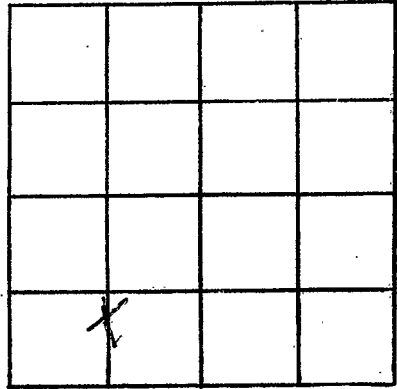

SECTION 8

Please indicate well location X.

ADDITIONAL INFORMATION

If more than one screen, show locations of each on sketch.