

PIKE
J 95
9-25-79

MISSISSIPPI
BOARD OF WATER COMMISSIONERS
416 North State Street
Jackson, Mississippi 39201

CODED

WATER WELL DRILLERS LOG

9-25-79 *Griner Drilling* *Pike*
date well completed firm name county well located

LANDOWNER:
Texaco
Columbo, Ms 39429
(mailing address)

description of formations encountered	from	to
<i>chalk</i>	<i>0</i>	<i>15</i>
<i>gravel & sand</i>	<i>15</i>	<i>315</i>

WELL LOCATION: *900' N + 200' E*
sec. *4 T 20 R 9* of *SW/4*
McComb - east
(distance) miles (direction) of (nearest town)

WELL PURPOSE: *oil field*
(home, irrigation, municipal, industrial)

- WELL COMPLETION DATA:
- (1) diameter (inches) *3"*
 - (2) total depth (feet) *315'*
 - (3) static water level (feet) *80'* ^{below} / _{above} top of ground
 - (4) casing *steel*, *315'*
(material) (depth)
 - 2"*
(size) If telescope see back.
 - (5) screen *42'*, *273'*
(length) (depth to top)
 - 3"* *perforated*
(size) (material)
 - (6) pump *70*
(HP) (yield gpm)
 - AC*
(type power)
 - (7) electric log _____
(yes or no)
 - _____
(organization running log)
 - (8) how well bottom plugged *orange*
peel

CODED

DEPT. OF NATURAL RESOURCES
BUREAU OF LAND & WATER RESOURCES


OCT 26 1979

DRILLERS REMARKS:

RECEIVED

If well telescopes please sketch and show depths.

GROUND LEVEL

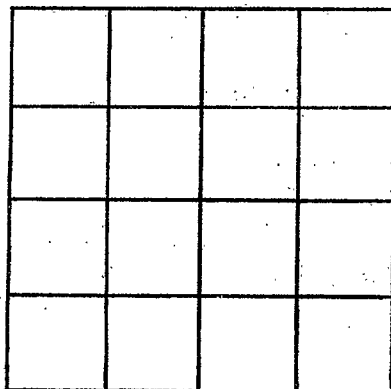

SECTION _____

Please indicate well location X.

ADDITIONAL INFORMATION

If more than one screen,
show locations of each on sketch.