

Pike
J 98
5-20-80

MISSISSIPPI
BOARD OF WATER COMMISSIONERS
416 North State Street
Jackson, Mississippi 39201

CODED

WATER WELL DRILLERS LOG

5-20-80 Griner Drilling Pike

date well completed

firm name

county well located

LANDOWNER:	description of formations encountered	from	to
Florida Gas + Exploration 1444 Capital Towers Jackson, MS 39205 (mailing address)	clay-sand	0	21
	gravel	21	42
WELL LOCATION: 330' N & 330' W NO 3 Pigott 4 T 20 R 90 E of Bogue Chitto 12 miles (distance) (direction) (nearest town)	rocks-gravel	42	63
	clay-sand	63	105
WELL PURPOSE: oil field supply (home, irrigation, municipal, industrial)	sand-gravel	105	231
	clay	231	252
WELL COMPLETION DATA:			
(1) diameter (inches) 3"			
(2) total depth (feet) 252'			
(3) static water level (feet) 65' below top of ground			
(4) casing steel, 231' (material) (depth) 3" if telescope see back. (size)			
(5) screen 42', 189' (length) (depth to top) 3" perforated (size) (material)			
(6) pump — 65 (HP) (yield gpm) AC (type power)			
(7) electric log <input checked="" type="checkbox"/> (yes or no) (organization running log)			
(8) how well bottom plugged red orange			
DRILLERS REMARKS:			


DEPT. OF NATURAL RESOURCES
BUREAU OF LAND & WATER RESOURCES

MAY 28 1980

RECEIVED

If well telescopes please sketch and show depths.

GROUND LEVEL

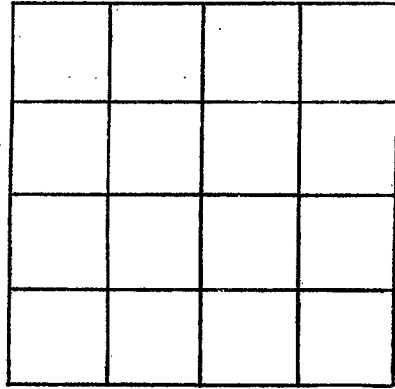

SECTION _____

Please indicate well location X.

ADDITIONAL INFORMATION

A series of horizontal lines for writing additional information, starting below the 'ADDITIONAL INFORMATION' header and extending to the bottom of the page.

If more than one screen, show locations of each on sketch.