

MISSISSIPPI DEPARTMENT OF NATURAL RESOURCES

Bureau of Land and Water Resources

Southport Mall

P.O. Box 10631

Jackson, Mississippi 39209

WATER WELL DRILLERS LOG

CODED

J 101
PIKE
5-18-84

5-18

date well completed

1984

F. L. L. Well Sew

firm name

Pike

county well located

LANDOWNER:

Sam Thomas

R.R. McComb, Ms.

(mailing address)

WELL LOCATION:

sec. 10 T-2 N

R-9 E

8

miles

E

of McComb

(distance)

(direction)

(nearest town)

WELL PURPOSE:

(home, irrigation, municipal, industrial)

WELL COMPLETION DATA:

- (1) diameter (inches) 4
- (2) total depth (feet) 250
- (3) static water level (feet) 75 below top of ground.
- (4) casing PVC 240, (material) (depth)
4 (size) If telescope see back.
- (5) screen 16 240 (length) (depth to top)
4 (size) PVC (material)
- (6) pump 1 1/2 25 (HP) (yield gpm)
Ch (type power)
- (7) electric log ne (yes or no)
(organization running log)
- (8) how well bottom plugged full

description of formations encountered

from

to

Red clay

0

20

Red sand

20

70

G. white chalk

70

235

Coarse sand & gravel

235

250

DEPT. OF NATURAL RESOURCES
BUREAU OF LAND & WATER RESOURCES


JUN 15 1984

RECEIVED

DRILLERS REMARKS:

If well telescopes please
sketch and show depths.

GROUND LEVEL

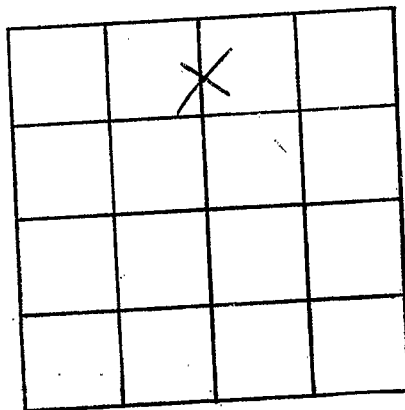

SECTION 10

Please indicate well location X.

ADDITIONAL INFORMATION

If more than one screen,
show locations of each on sketch.