

MISSISSIPPI DEPARTMENT OF NATURAL RESOURCES

Bureau of Land and Water Resources

Southport Mall
P.O. Box 10631 **CODED**

Jackson, Mississippi 39209

WATER WELL DRILLERS LOG

J102
PIKE
5-19-84

5-19

1984

Figueroa well service

Pike

date well completed

firm name

county well located

LANDOWNER:

Sam Thomas

BB. McComb, ms.
(mailing address)

description of formations encountered

from

to

<i>Red clay</i>	<i>0</i>	<i>20</i>
<i>red granite</i>	<i>20</i>	<i>30</i>
<i>White & blue chalk</i>	<i>30</i>	<i>115</i>
<i>Coarse sandstone</i>	<i>115</i>	<i>130</i>

WELL LOCATION:

sec. 10 T 2N S R 9 E W
8 miles E of McComb
(distance) (direction) (nearest town)

WELL PURPOSE:

(home, irrigation, municipal, industrial)

WELL COMPLETION DATA:

- (1) diameter (inches) 4
- (2) total depth (feet) 130
- (3) static water level (feet) 4 below above top of ground.
- (4) casing PVC, 122,
(material) (depth)
4
(size) if telescope see back.
- (5) screen 8, 123
(length) (depth to top)
4, PVC
(size) (material)
- (6) pump 1, 20
(HP) (yield gpm)
cla
(type power)
- (7) electric log No
(yes or no)
(organization running log)
- (8) how well bottom plugged Salt brk

DEPT. OF NATURAL RESOURCES
BUREAU OF LAND & WATER RESOURCES


JUN 13 1984

RECEIVED

DRILLERS REMARKS:

If well telescopes please sketch and show depths.

GROUND LEVEL

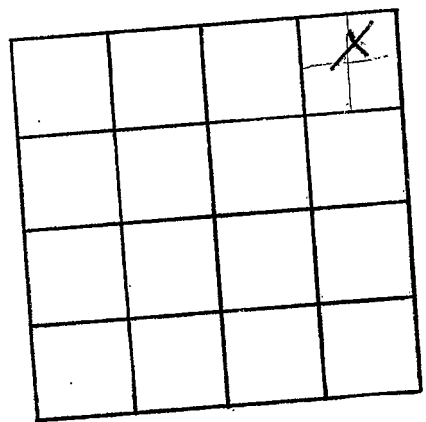

SECTION 10

Please indicate well location X.

ADDITIONAL INFORMATION

A series of horizontal lines for writing additional information, located below the 'ADDITIONAL INFORMATION' header.

If more than one screen, show locations of each on sketch.