

MISSISSIPPI DEPARTMENT OF NATURAL RESOURCES

Bureau of Land and Water Resources

Southport Mall

P.O. Box 10631

Jackson, Mississippi 39209

WATER WELL DRILLERS LOG

Pike
J103

4-19-85 19 stepped water well ser. Pike Co.
date well completed firm name county well located


LANDOWNER: James Ruskey
Pt. 2
McClouch Mr. 39648
(mailing address)

WELL LOCATION:
sec. 18 T 2 N R 9 E
S W
9 miles east of Magnolia
(distance) (direction) (nearest town)

WELL PURPOSE: none
(home, irrigation, municipal, industrial)

WELL COMPLETION DATA:
(1) diameter (inches) 2 1/2"
(2) total depth (feet) 120'
(3) static water level (feet) 100' below top of ground.
(4) casing plastic / 120
(material) (depth)
(size) If telescope see back.
(5) screen 10' / 100
(length) (depth to top)
4" / plastic
(size) (material)
(6) pump 1 1/2
(HP) (yield gpm)
(type power)
(7) electric log yes or no
(organization running log)
(8) how well bottom plugged barrel
shank

description of formations encountered	from	to
top soil	0	6"
sand and gravel	6"	75'
white chalk	75'	100'
water sand & gravel	100'	120'

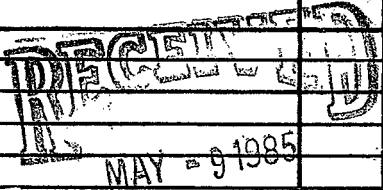


DRILLERS REMARKS: well drilled by C. S. & J. S. [unclear]

Department of Natural Resources
Bureau of Land & Water Resources

If well telescopes please
sketch and show depths.

GROUND LEVEL

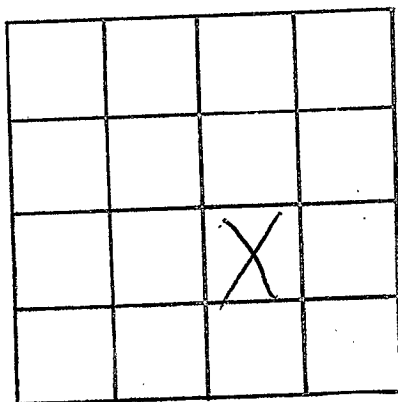

SECTION 18

Please indicate well location X.

ADDITIONAL INFORMATION

If more than one screen,
show locations of each on sketch.