

MISSISSIPPI DEPARTMENT OF NATURAL RESOURCES

Bureau of Land and Water Resources

Southport Mall

P.O. Box 10631

Jackson, Mississippi 39209

WATER WELL DRILLERS LOG

CODED

Griner Drilling Service, Inc.

Dike

PIKE
J104
10-9-85

10-9-85 date well completed

Griner Drilling Service, Inc. firm name

Dike county well located

LANDOWNER:

Helmerich & Payne  
P.O. Box 6173  
Pearl, Ms. 39208  
(mailing address)

description of formations encountered

from

to

fill & clay CODED 0 45  
SAND, DEA gravel 45 275

WELL LOCATION:

689' N + 2140' W  
sec. 7 T 2 N R 9 E of  
NO. 7-15  
W. W. Moses McComb  
(distance) miles (direction) (nearest town)

WELL PURPOSE: oilfield supply  
(home, irrigation, municipal, industrial)

WELL COMPLETION DATA:

- (1) diameter (inches) 4"
- (2) total depth (feet) 275'
- (3) static water level (feet) 70' below top of ground.
- (4) casing steel 273' (material) (depth)  
3" (size) if telescope see back.
- (5) screen 42' 231' (length) (depth to top)  
3" perforated (size) (material)
- (6) pump - 75-80 (HP) (yield gpm)  
AC (type power)
- (7) electric log (yes or no)

(organization running log)

- (8) how well bottom plugged orange  
peel

DRILLERS REMARKS:


RECEIVED

NOV -1 1985

Department of Natural Resources  
Bureau of Land & Water Resources

If well telescopes please sketch and show depths.

GROUND LEVEL

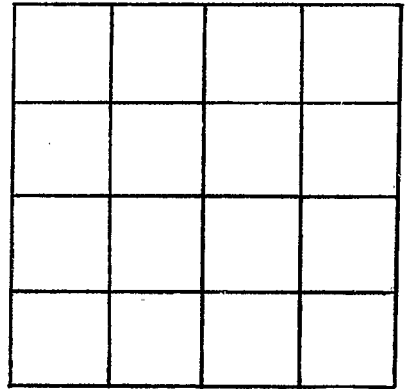

SECTION \_\_\_\_\_

Please indicate well location X.

ADDITIONAL INFORMATION

If more than one screen,  
show locations of each on sketch.