

MISSISSIPPI DEPARTMENT OF NATURAL RESOURCES
 Bureau of Land and Water Resources
 Southport Mall
 P.O. Box 10631
 Jackson, Mississippi 39209
WATER WELL DRILLERS LOG

PIKE
J105

CODED


7/17 1986 Morris Bros., Inc. Pike
 date well completed firm name county well located

LANDOWNER: Judice Oil Co.
P.O. Drawer N
Lava, La. 71342
 (mailing address)

WELL LOCATION: Pike County
 sec. 7 T. 2 N. R. 9 E
11 miles E. of McLamb
 (distance) (direction) (nearest town)

WELL PURPOSE: rig supply
 (home, irrigation, municipal, industrial)


- WELL COMPLETION DATA:**
- (1) diameter (inches) 778"
 - (2) total depth (feet) 282'
 - (3) static water level (feet) 72' below top of ground.
 - (4) casing PVC sch 40, 236' (material) (depth)
4" (size) if telescope see back.
 - (5) screen 20', 236' (length) (depth to top)
4", PVC sch 40 (size) (material)
 - (6) pump 7 1/2 (HP) 1004 gpm (yield gpm)
elec. motor (type power)
 - (7) electric log No (yes or no)
 (organization running log)
 - (8) how well bottom plugged well
wash

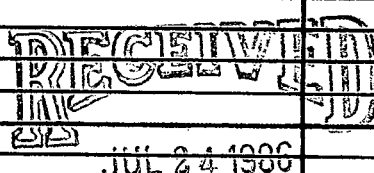description of formations encountered	from	to
<u>med clay</u>	<u>0</u>	<u>20'</u>
<u>med sand (med.)</u>	<u>20</u>	<u>60'</u>
<u>sand: fine gravel</u>	<u>60</u>	<u>120'</u>
<u>coarse sand: gravel</u>	<u>120</u>	<u>200'</u>
<u>med. wh. sand</u>	<u>200</u>	<u>240'</u>
<u>coarse wh. sand w/ gravel</u>	<u>240</u>	<u>282'</u>
<u>Oil rig location</u>		
<u>330' N + 330' E of</u>		
<u>SW/4 cor NE SE Sec. 7</u>		
<u>2N 9E</u>		
CODED		
		
Department of Natural Resources Bureau of Land & Water Resources		

DRILLERS REMARKS:

If well telescopes please sketch and show depths.

GROUND LEVEL

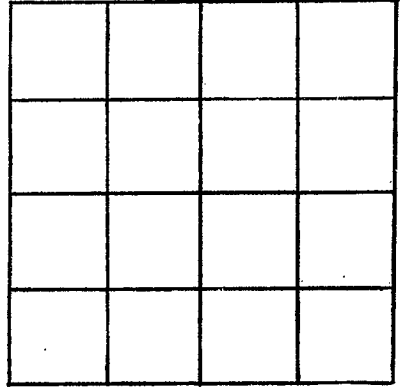

SECTION _____

Please indicate well location X.

ADDITIONAL INFORMATION

If more than one screen, show locations of each on sketch.